

C26

WILKINSON
SIZ
1-11-74

MISSISSIPPI
BOARD OF WATER COMMISSIONERS
416 North State Street
Jackson, Mississippi 39201

CODED
CODED

WATER WELL DRILLERS LOG

1-11 1974 *Rayburn Drilling Flouret Co. Wilkinson*
date well completed firm name county well located

LANDOWNER:
W. G. Johnson
Crosby, Miss.
(mailing address)

description of formations encountered	from	to
<i>Top soil</i>	<i>0</i>	<i>1</i>
<i>red clay</i>	<i>1</i>	<i>10</i>
<i>gray clay</i>	<i>10</i>	<i>86</i>
<i>fine sand</i>	<i>86</i>	<i>130</i>
<i>coarse sand</i>	<i>130</i>	<i>155</i>

WELL LOCATION:
sec. *17* T. *4* N. R. *1* E
S. *6* miles *West* of *Roxetta*
(distance) (direction) (nearest town)

WELL PURPOSE: *Home*
(home, irrigation, municipal, industrial)


- WELL COMPLETION DATA:
- (1) diameter (inches) *2"*
 - (2) total depth (feet) *155'*
 - (3) static water level (feet) *70'* below above top of ground.
 - (4) casing *Galv.* *147'*
(material) (depth)
2" if telescope see back.
(size)
 - (5) screen *5'* *147'*
(length) (depth to top)
2" *155"*
(size) (material)
 - (6) pump _____ (HP) _____ (yield gpm)
(type power)
 - (7) electric log *no*
(yes or no)
(organization running log)
 - (8) how well bottom plugged *wood plug*

CODED

DRILLERS REMARKS:

If well telescopes please sketch and show depths.

GROUND LEVEL

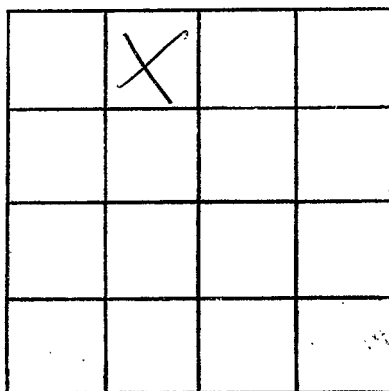

SECTION 12

Please indicate well location X.

ADDITIONAL INFORMATION

If more than one screen,
show locations of each on sketch.