

WILKINSON
C 27
1-18-82

MISSISSIPPI DEPARTMENT OF NATURAL RESOURCES
Bureau of Land and Water Resources
Southport Mall
P.O. Box 10631
Jackson, Mississippi 39209
WATER WELL DRILLERS LOG

CODED

1-18-82 date well completed
1982 Progressive Drilling & Prod. Wilkinson firm name
county well located

LANDOWNER:
D & D Drilling
Terrebonne La. 71334
(mailing address)

description of formations encountered	from	to
top soil	0	2
gumbo	2	180
sand	180	340

WELL LOCATION:
sec. 18 T. 4 N. R. 1 E
4 miles West of Resette
(distance) (direction) (nearest town)

WELL PURPOSE:
(home, irrigation, municipal, industrial)

WELL COMPLETION DATA:

- (1) diameter (inches) 3"
- (2) total depth (feet) 340'
- (3) static water level (feet) 120' ^{below} top of ground
- (4) casing 1 1/2" (material), 320' (depth)
3" if telescope see back. (size)
- (5) screen 20' (length), 320' (depth to top)
3" (size), slotted pipe (material)
- (6) pump 50 (HP) 50 (yield gpm)
(type power)
- (7) electric log no (yes or no)
(organization running log)
- (8) how well bottom plugged wood plug

948' N + 896' W
of SE 1/4 cor. of Sec. 18
USA 18-16 #1

CODED

DEPT. OF NATURAL RESOURCES
BUREAU OF LAND & WATER RESOURCES


JAN 22 1982

RECEIVED

DRILLERS REMARKS:

If well telescopes please sketch and show depths.

GROUND LEVEL

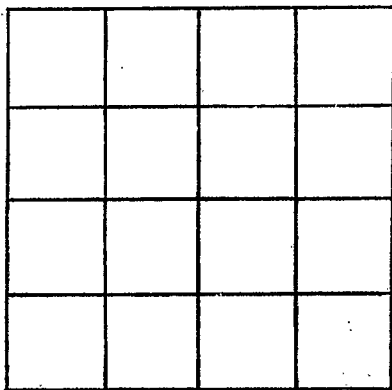

SECTION _____

Please indicate well location X.

ADDITIONAL INFORMATION

If more than one screen,
show locations of each on sketch.