

MISSISSIPPI DEPARTMENT OF NATURAL RESOURCES

Bureau of Land and Water Resources

Southport Mall

P.O. Box 10631

Jackson, Mississippi 39209

CODED

WATER WELL DRILLERS LOG

Wilkinson  
C28  
5-6-82

5-6-82 date well completed  
Raytown Drilling & Const Co. firm name  
Wilkinson county well located

LANDOWNER:	description of formations encountered	from	to
Adco Producing Co.	Top soil	0	2
Natchez, MS 39120 (mailing address)	Sand	2	10
WELL LOCATION:	Shell	10	180
sec. 29 T40N R1E S	Sand	180	235
(distance) miles (direction) of (nearest town)	Gumbo	235	240
WELL PURPOSE: (home, irrigation, municipal, industrial)	Sand	240	298
WELL COMPLETION DATA:	Gumbo	298	310
(1) diameter (inches) 3"	AND	310	335
(2) total depth (feet) 335'			
(3) static water level (feet) 120' below top of ground.			
(4) casing Blk. 335' (material) (depth) 3" (size) if telescope see back.			
(5) screen 20' 315' (length) (depth to top) 3" (size) Galv. Pipe (material)			
(6) pump 52 (HP) (yield gpm)			
(type power)			
(7) electric log (yes or no)			
(organization running log)			
(8) how well bottom plugged Wood Plug			
DRILLERS REMARKS:			

WASH - 29-3

38' 3" 265' E 1/4 NW 1/4 OF SEC. 29


DEPT. OF NATURAL RESOURCES  
BUREAU OF LAND & WATER RESOURCES

MAY 10 1982

RECEIVED

If well telescopes please  
sketch and show depths.

GROUND LEVEL

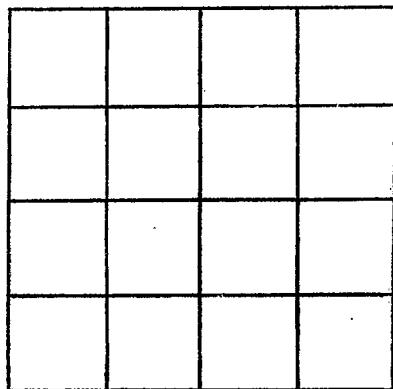

SECTION \_\_\_\_\_

Please indicate well location X.

ADDITIONAL INFORMATION

If more than one screen,  
show locations of each on sketch.