

**WILKINSON**  
**C 29**  
**10/11/82**

**MISSISSIPPI DEPARTMENT OF NATURAL RESOURCES**  
 Bureau of Land and Water Resources  
 Southport Mall  
 P.O. Box 10631  
 Jackson, Mississippi 39209  
**WATER WELL DRILLERS LOG**

10-11 1982 Rayham Drill & Const Co. Wilkinson  
 date well completed firm name county well located

**LANDOWNER:**  
Shennock Drilling Co.  
Natchez, MS 39130  
 (mailing address)

| description of formations encountered | from     | to         |
|---------------------------------------|----------|------------|
| <u>Top soil</u>                       | <u>0</u> | <u>5</u>   |
| <u>clay</u>                           | <u>5</u> | <u>270</u> |

**WELL LOCATION:**  
 sec. 33 T 4 N S R 1 E W  
 \_\_\_\_\_ miles \_\_\_\_\_ of \_\_\_\_\_  
 (distance) (direction) (nearest town)

|                   |            |            |
|-------------------|------------|------------|
| <u>stratified</u> | <u>270</u> | <u>360</u> |
| <u>sand</u>       | <u>360</u> | <u>420</u> |

**WELL PURPOSE:**  
 (home, irrigation, municipal, industrial)

330' N + 660' W of

**WELL COMPLETION DATA:**

SE cor. of Sec. 33

(1) diameter (inches) 4" 3"

(2) total depth (feet) 420'

(3) static water level (feet) 100' below above top of ground.

(4) casing Blk 400'  
 (material) (depth)  
3"  
 (size) if telescope see back.

USA 33-16

(5) screen 20' 400'  
 (length) (depth to top)

3" slotted pipe  
 (size) (material)

**CODED**

(6) pump — 42 GPM  
 (HP) (yield gpm)

(type power)

(7) electric log no  
 (yes or no)

(organization running log)

DEPT. OF NATURAL RESOURCES  
 BUREAU OF LAND & WATER RESOURCES

NOV - 5 1982


(8) how well bottom plugged wood plug

**RECEIVED**

**DRILLERS REMARKS:**

If well telescopes please  
sketch and show depths.

GROUND LEVEL

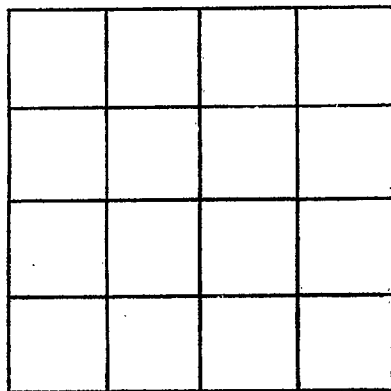

SECTION \_\_\_\_\_

Please indicate well location X.

ADDITIONAL INFORMATION

If more than one screen,  
show locations of each on sketch.