

MISSISSIPPI DEPARTMENT OF NATURAL RESOURCES

Bureau of Land and Water Resources

Southport Mall

P.O. Box 10631

Jackson, Mississippi 39209

WATER WELL DRILLERS LOG

Wilkinson  
L 30  
12/82

12-3  
 date well completed

1982 Rayburn Drilling  
 firm name

Wilkinson  
 county well located

LANDOWNER:  
Shamrock Drilling  
Datches No 39120  
 (mailing address)

description of formations encountered	from to	
<u>topsoil</u>	<u>0</u>	<u>5</u>
<u>clay</u>	<u>5</u>	<u>210</u>
<u>shale</u>	<u>210</u>	<u>310</u>
<u>sand</u>	<u>310</u>	<u>342</u>

WELL LOCATION:  
 sec. 33 T 4 (N) R 1 E  
4 miles SE of DeLoach  
 (distance) (direction) (nearest town)

USA CC-1

WELL PURPOSE:  
 (home, irrigation, municipal, industrial)

1269' S & 2240' W of NE 1 cor

- WELL COMPLETION DATA:
- (1) diameter (inches) 3"
  - (2) total depth (feet) 342'
  - (3) static water level (feet) 150 (below above top of ground)
  - (4) casing PRC, 372'  
 (material) (depth)  
3" if telescope see back.  
 (size)
  - (5) screen 20', 372'  
 (length) (depth to top)  
3", slotted pipe  
 (size) (material)
  - (6) pump -, 45  
 (HP) (yield gpm)  
elec  
 (type power)
  - (7) electric log -  
 (yes or no)  
-  
 (organization running log)
  - (8) how well bottom plugged wood plug

SEC 33, TAN, R 1 W

CODED

DEPT. OF NATURAL RESOURCES  
 BUREAU OF LAND & WATER RESOURCES


DEC 10 1982

RECEIVED

DRILLERS REMARKS:

If well telescopes please  
sketch and show depths.

GROUND LEVEL

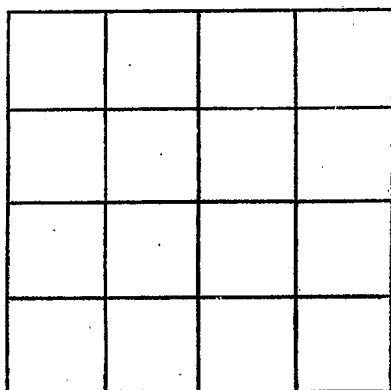

SECTION \_\_\_\_\_

Please indicate well location X.

ADDITIONAL INFORMATION

If more than one screen,  
show locations of each on sketch.