

MISSISSIPPI DEPARTMENT OF NATURAL RESOURCES

Bureau of Land and Water Resources

Southport Mall

P.O. Box 10631

Jackson, Mississippi 39209

WATER WELL DRILLERS LOG

CODED

WILKINSON
C 31
6/4/83

6/4/83 date well completed 1983 firm name *Rambon Drilling & Const.* county well located *Wilkinson*

LANDOWNER:	description of formations encountered	from	to
<i>D & D Drilling Co.</i>	<i>Top Soil</i>	<i>0</i>	<i>4</i>
<i>Ferriday, L.A.</i> (mailing address)	<i>Shovel</i>	<i>5</i>	<i>40</i>
WELL LOCATION: sec. <i>36</i> -T- <i>4</i> S R- <i>1</i> E W	<i>Chalk</i>	<i>41</i>	<i>160</i>
(distance) miles (direction) of (nearest town)	<i>Sand</i>	<i>161</i>	<i>180</i>
WELL PURPOSE: (home, irrigation, municipal, industrial)	<i>Chalk</i>	<i>181</i>	<i>280</i>
WELL COMPLETION DATA:	<i>Sand</i>	<i>281</i>	<i>345</i>
(1) diameter (inches) <i>3"</i>	<i>Break</i>	<i>346</i>	<i>351</i>
(2) total depth (feet) <i>495'</i>	<i>Sand</i>	<i>352</i>	<i>495</i>
(3) static water level (feet) <i>220'</i> below top of ground.			
(4) casing <i>Blk</i> <i>475'</i> (material) (depth)			
<i>3"</i> (size) if telescope see back.			
(5) screen <i>20'</i> <i>475'</i> (length) (depth to top)			
<i>3"</i> <i>slotted Pipe</i> (size) (material)			
(6) pump <i>50 GPM</i> (HP) (yield gpm)			
(type power)			
(7) electric log <i>NO</i> (yes or no)			
(organization running log)			
(8) how well bottom plugged <i>Wood Plug</i>			
DRILLERS REMARKS:			

CODED

Federal Perm #1


DEPT. OF NATURAL RESOURCES
BUREAU OF LAND & WATER RESOURCES

JUN 22 1983

RECEIVED

If well telescopes please sketch and show depths.

GROUND LEVEL

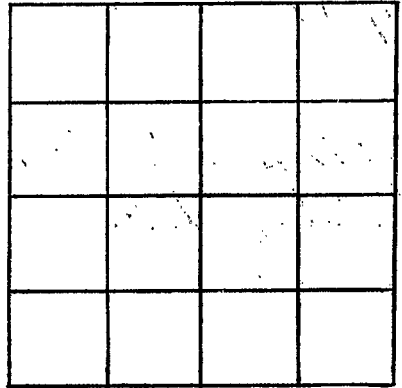

SECTION _____

Please indicate well location X.

ADDITIONAL INFORMATION

If more than one screen,
show locations of each on sketch.