

MISSISSIPPI DEPARTMENT OF NATURAL RESOURCES
Bureau of Land and Water Resources
 Southport Mall
 P.O. Box 10631
 Jackson, Mississippi 39209
WATER WELL DRILLERS LOG

CODED

WILKINSON
C 32
6/13/83

6/13/83 19 83 Rayton Drilling & Cont. Wilkinson
 date well completed firm name county well located

LANDOWNER:
D & D Drilling Co.
Ferriday, La.
 (mailing address)

description of formations encountered	from	to
<u>Top Soil</u>	<u>0</u>	<u>7</u>
<u>Sand</u>	<u>8</u>	<u>30</u>
<u>Gravel</u>	<u>31</u>	<u>220</u>
<u>Sand</u>	<u>221</u>	<u>280</u>
<u>Shale</u>	<u>281</u>	<u>360</u>
<u>Sand</u>	<u>361</u>	<u>474</u>

WELL LOCATION:
 sec 35 T 4 N R 1 E
S W
2 miles West of Woodville
 (distance) (direction) (nearest town)

WELL PURPOSE: oil field
 (home, irrigation, municipal, industrial)

WELL COMPLETION DATA:

(1) diameter (inches) 3"

(2) total depth (feet) 474'

(3) static water level (feet) 220' below top of ground.

(4) casing Blk 464'
 (material) (depth)
3" if telescope see back.
 (size)

(5) screen 10' 464'
 (length) (depth to top)
3" slotted
 (size) (material)

(6) pump — 50 GPM
 (HP) (yield gpm)

—
 (type power)

(7) electric log NO
 (yes or no)

—
 (organization running log)

CODED

Derrington #1

(8) how well bottom plugged Wood Plug

DEPT. OF NATURAL RESOURCES
 BUREAU OF LAND & WATER RESOURCES


NOV 28 1983

DRILLERS REMARKS:

RECEIVED

If well telescopes please sketch and show depths.

GROUND LEVEL

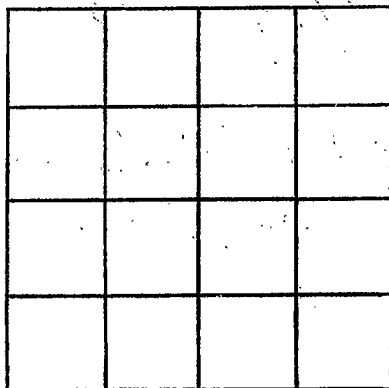

SECTION _____

Please indicate well location X.

ADDITIONAL INFORMATION

If more than one screen, show locations of each on sketch.