

MISSISSIPPI DEPARTMENT OF NATURAL RESOURCES

Bureau of Land and Water Resources

Southport Mall

P.O. Box 10631

Jackson, Mississippi 39209

WATER WELL DRILLERS LOG

CODED

WILKINSON  
C33

7/13/84 date well completed 1984 firm name Rayborn Drilling county well located Wilkinson

LANDOWNER:  
Trace Drilling  
Natchez, MS<sup>30</sup>  
(mailing address)

description of formations encountered	from	to
Top Soil	0	2
Gumbo	3	55
Sand	56	80

WELL LOCATION:  
sec. 40 T. 50 N. R. 1 E. S. 3  
3 miles SW of Brown  
(distance) (direction) (nearest town)

CODED

WELL PURPOSE: oil field  
(home, irrigation, municipal, industrial)

- WELL COMPLETION DATA:
- (1) diameter (inches) 3"
  - (2) total depth (feet) 80'
  - (3) static water level (feet) 10' below top of ground.
  - (4) casing: blk pipe, 100' (material) (depth)  
3" (size) If telescope see back.
  - (5) screen: 20' 100' (length) (depth to top)  
3" slotted pipe (size) (material)
  - (6) pump: 50 (HP) (yield gpm)
  - (type power)
  - (7) electric log: no (yes or no)  
(organization running log)
  - (8) how well bottom plugged: wood

beale name:  
Cecilia #1


DRILLERS REMARKS:

DEPT. OF NATURAL RESOURCES  
BUREAU OF LAND & WATER RESOURCES

RECEIVED  
OCT 31 1984

If well telescopes please sketch and show depths.

GROUND LEVEL

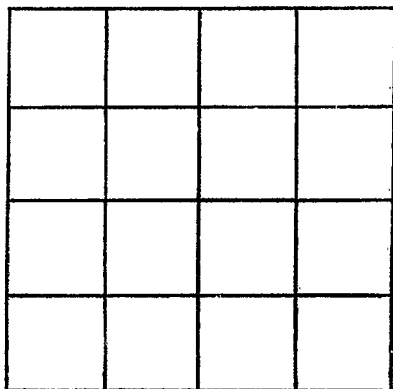

SECTION \_\_\_\_\_

Please indicate well location X.

ADDITIONAL INFORMATION

If more than one screen, show locations of each on sketch.