

MISSISSIPPI DEPARTMENT OF NATURAL RESOURCES
 Bureau of Land and Water Resources
 Southport Mall
 P.O. Box 10631
 Jackson, Mississippi 39209
WATER WELL DRILLERS LOG

CODED

C 34
 Wilkinson
 8-11-85

8/11 1985 Rayborn Drilling Co. Wilkinson
 date well completed firm name county well located

LANDOWNER: <u>David New Drilling Co.</u>	description of formations encountered	from	to
<u>PO Box 1487</u>			
<u>Natchez Ms 39120</u> (mailing address)	<u>Gumbo</u>	<u>10</u>	<u>30</u>
WELL LOCATION: sec. <u>40</u> T. <u>5</u> (N) R. <u>1</u> (E) <u>9</u> miles <u>NE</u> of <u>Doloroso</u> (distance) (direction) (nearest town)	<u>Sand</u>	<u>30</u>	<u>80</u>
WELL PURPOSE: (home, irrigation, municipal, industrial)	<u>fr sec/cor sec 40 gn W'ly</u>		
WELL COMPLETION DATA:	<u>alg sec/cor 1792' th W'ly</u>		
(1) diameter (inches) <u>3"</u>	<u>@ KA 1017' to loc sec 40-5N-1W</u>		
(2) total depth (feet) <u>80'</u>			
(3) static water level (feet) <u>40'</u> <u>below</u> above top of ground.			
(4) casing <u>PVC Pipe</u> , <u>70'</u> (material) (depth) <u>3"</u> (size) if telescope see back.	<u>Lease Name:</u> <u>Alexander # 1</u>		
(5) screen <u>10'</u> , <u>70'</u> (length) (depth to top) <u>3"</u> , <u>PVC Slotted Pipe</u> (size) (material)			
(6) pump <u>—</u> , <u>50</u> (HP) (yield gpm) <u>electric</u> (type power)			
(7) electric log <u>no</u> (yes or no) <u>—</u> (organization running log)			
(8) how well bottom plugged <u>wood</u>			


RECEIVED

OCT - 8 1985


Department of Natural Resources
 Bureau of Land & Water Resources

DRILLERS REMARKS:

If well telescopes please sketch and show depths.

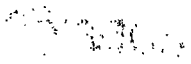

GROUND LEVEL

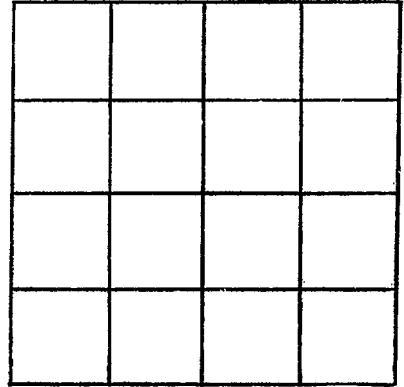

SECTION _____

Please indicate well location X.

ADDITIONAL INFORMATION

If more than one screen,
show locations of each on sketch.