

MISSISSIPPI DEPARTMENT OF NATURAL RESOURCES

Bureau of Land and Water Resources

Southport Mall

P.O. Box 10631

Jackson, Mississippi 39209

WATER WELL DRILLERS LOG

CODED

WILKINSON  
C035

10/21 1985 Rayborn Drilling Co Wilkinson  
date well completed firm name county well located

LANDOWNER: D & D Drig Co PO Box 351 Ferniday LA 71334 (mailing address)	description of formations encountered	from	to
	Top Soil	0	3
	Chalk	3	100
WELL LOCATION: sec. 18 T. 4 N. R. 1 E. S. W. W 7 miles W of Rosetta (distance) (direction) (nearest town)	Ratty Sand	100	200
	Sand	200	315
WELL PURPOSE: oilfield (home, irrigation, municipal, industrial)			
WELL COMPLETION DATA: (1) diameter (inches) 3" (2) total depth (feet) 315' (3) static water level (feet) 100' below top of ground. (4) casing blk pipe, 295' (material) (depth), 3" (size) if telescope see back. (5) screen 20' (length), 295' (depth to top), 3" (size), slotted blk pipe (material) (6) pump - (HP), 50 (yield gpm) (type power) (7) electric log no (yes or no) (organization running log) (8) how well bottom plugged wood	1971 S + 330' W of NE/cor  Well Name: Perry Unit # 1		


DRILLERS REMARKS:

APR 8 1986

Department of Natural Resources  
Bureau of Land and Water Resources

If well telescopes please  
sketch and show depths.

GROUND LEVEL

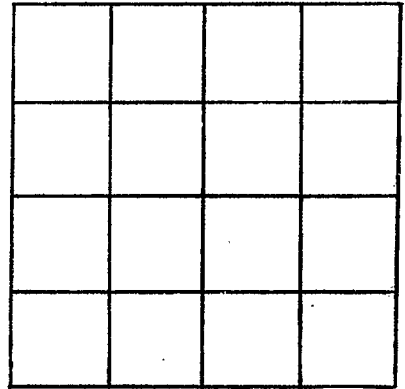

SECTION \_\_\_\_\_

Please indicate well location X.

ADDITIONAL INFORMATION

If more than one screen,  
show locations of each on sketch.