

MISSISSIPPI DEPARTMENT OF NATURAL RESOURCES

Bureau of Land and Water Resources

COUNTY WELL LOCATED Wilkinson	
WELL NUMBER Thornburg-	CODED <input checked="" type="checkbox"/>
Murray # IC37	
DATE WELL COMPLETED 8-25-87	

PERMIT NUMBER
NAME OF DRILLING FIRM RAYBORN DRILLING, INC.

P.O. Box 10631
Jackson, Mississippi 39209
WATER WELL DRILLERS LOG

NAME & MAILING ADDRESS OF LANDOWNER D & D Drilling Co.		
P.O. Box 351		
Ferriday LA 71334		
WELL LOCATION: SEC	TOWNSHIP	RANGE
17	4	N S 1
DISTANCE DIRECTION NEAREST TOWN 5 Miles W of Rosetta		
OTHER LANDMARK		
WELL PURPOSE: Home, Irrigation, Municipal, Industrial, Fish Pond, etc. Oilfield		

PUMP DATA		
PUMP TYPE (Circle One): Submersible, Turbine, Jet, Flowing Well, Other (Describe) <u>Air</u>		
POWER TYPE (Circle One): Electric, Tractor, Diesel, Gasoline, Butane, Other (Describe) _____		
Pump Capacity (GPM) N/A	No. of Stages	Setting Depth FT.
PUMP TEST Well yielded 50 GPM with a drawdown of _____ ft. after _____ hours of pumping		

WELL DATA		
Well Depth 180'	Casing Diameter (In.) 3"	Casing Length (Ft.) 160'
Type of Casing SCH 40 PVC	Hole Depth 180'	Depth to Static Water Level 50'
TYPE OF COMPLETION: (Circle One or More): <input checked="" type="checkbox"/> Gravel Packed, <input type="checkbox"/> Underreamed, <input type="checkbox"/> Telescoped, <input checked="" type="checkbox"/> Natural Development, <input type="checkbox"/> Open Hole, <input type="checkbox"/> Other		
Top of Lap Pipe or Reduction in Casing FEET IF TELESCOPED OR MORE THAN ONE SCREEN: USE BACK PAGE		

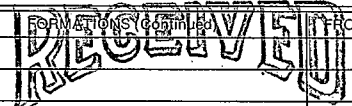
LOG DATA	
TYPE OF LOG RUN (Circle One): Electric, Gamma Ray, Density, Sonic, Neutron, Other (Describe) <u>No Log Run</u>	
Name of Organization Running Log	

SCREEN DATA		
Diameter - Inches 3"	Length - Feet 20'	Slot Size - Inches .020
Screen Type Slotted Sch 40 PVC	Depth to Bottom, Feet 160'	

GEOLOGIC DATA (Office Use Only)			
Surface Elev.	Geologic Unit	Unit Thickness	Depth to Top
Subs. SWL	Date	Analysis	Aquifer Test

Driller's Remarks

DESCRIPTION OF FORMATIONS ENCOUNTERED	FROM	TO
Top Soil	0	15
Pea Gravel	15	30
Chalk	30	80
Sand	80	180

 AUG 28 1987 Department of Natural Resources Bureau of Land & Water Resources
IF MORE SPACE IS NEEDED, USE BACK

If well telescopes please
sketch and show depths.

GROUND LEVEL

SECTION _____

Please indicate well location X.

ADDITIONAL INFORMATION

If more than one screen,
show location of each on sketch.
