

MISSISSIPPI DEPARTMENT OF NATURAL RESOURCES

Bureau of Land and Water Resources

Southport Mall

P.O. Box 10631

Jackson, Mississippi 39209

WATER WELL DRILLERS LOG

CODED

WILKINSON
C 38
11-29-86

11/29 1986 Tom Griff. Th. Well Ser. Wilkinson
 date well completed firm name county well located

LANDOWNER: <u>Energy Drilling Co</u>	description of formations encountered	from	to
<u>PO Box 905</u> <u>Natchez, Ms 39120</u> (mailing address)			
	<u>hard clay</u>	<u>0</u>	<u>40</u>
	<u>sand</u>	<u>40</u>	<u>70</u>
	<u>hard clay</u>	<u>70</u>	<u>105</u>
	<u>sand</u>	<u>105</u>	<u>360</u>

WELL LOCATION:
 sec. 14 T 4 N R 1 E Crusoe
9 miles NW of Centerville
 (distance) (direction) (nearest town)

CODED

WELL PURPOSE: Oil Rig
 (home, irrigation, municipal, industrial)

WELL COMPLETION DATA:

- (1) diameter (inches) 3"
- (2) total depth (feet) 360
- (3) static water level (feet) 75 below top of ground.
- (4) casing PVC, 320,
 (material) (depth)
3" if telescope see back.
 (size)
- (5) screen 40, 320
 (length) (depth to top)
3", .025 slotted PVC
 (size) (material)
- (6) pump Art lift, 70
 (HP) (yield gpm)
direct
 (type power)
- (7) electric log NO
 (yes or no)
NA
 (organization running log)
- (8) how well bottom plugged BWV

901' N + 1706' W of SE corner

RECEIVED


SEP 24 1987

Department of Natural Resources
 Bureau of Land & Water Resources

DRILLERS REMARKS:

If well telescopes please sketch and show depths.

GROUND LEVEL

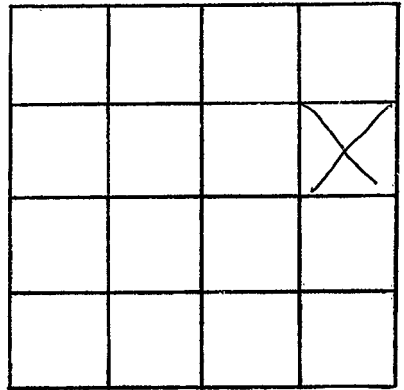

SECTION 14

Please indicate well location X.

ADDITIONAL INFORMATION

If more than one screen,
show locations of each on sketch.