

**Wilkinson**  
 C 2000  
 3-2-76

MISSISSIPPI  
 BOARD OF WATER COMMISSIONERS  
 416 North State Street  
 Jackson, Mississippi 39201

WATER WELL DRILLERS LOG

3-2 1976 date well completed  
 Rayborn Drilling & Const. Co. - Wilkinson firm name  
 county well located

LANDOWNER:  
 Johnson Bros.  
 (mailing address)  
 WELL LOCATION:  
 sec. 17 T 4 N R 1 E  
 S  
 6 miles west of Rosetta  
 (distance) (direction) (nearest town)

WELL PURPOSE:  
 Home  
 (home, irrigation, municipal, industrial)

WELL COMPLETION DATA:  
 (1) diameter (inches) 2"  
 (2) total depth (feet) 160'  
 (3) static water level (feet) 46' below top of ground.  
 (4) casing 2" (size) if telescope see back.  
 (material) galv. (depth) 153'  
 (5) screen 2" (size) 5' (length) 153' (depth to top)  
 (material) 55"  
 (6) pump (HP) (yield gpm)  
 (type power)  
 (7) electric log (yes or no) No  
 (organization running log)  
 (8) how well bottom plugged well plug


description of formations encountered	from	to
Top Soil	0	2
red clay	2	8
grey clay	8	87
fine sand	87	120
coarse sand	120	160

DRILLERS REMARKS:

MAR 24 1976  
 MISS. BU. OF WATER COMMISSIONERS

If well telescopes please sketch and show depths.

GROUND LEVEL

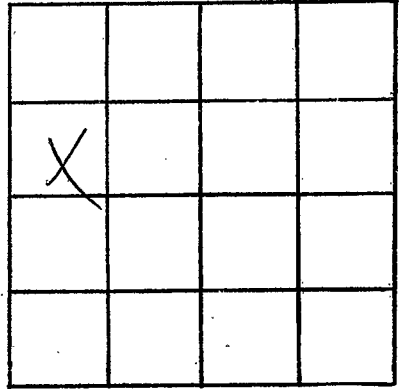

SECTION 17

Please indicate well location X.

ADDITIONAL INFORMATION

If more than one screen, show locations of each on sketch.