

WILKINSON  
C 2002  
9-21-76

MISSISSIPPI  
 BOARD OF WATER COMMISSIONERS  
 416 North State Street  
 Jackson, Mississippi 39201

WATER WELL DRILLERS LOG

9-21 1976 Rayburn Drilling & Const. Co. Wilkinson  
 date well completed firm name county well located


LANDOWNER:	description of formations encountered	from	to
<u>H. E. Smith</u>			
<u>Rt # 1 Box 25</u>	<u>brown clay</u>	<u>1</u>	<u>5</u>
<u>Crashy, Miss (mailing address)</u>	<u>blue clay</u>	<u>5</u>	<u>130</u>
	<u>sand</u>	<u>130</u>	<u>200</u>
<b>WELL LOCATION:</b>			
sec <u>40</u> T <u>4</u> S R <u>1</u> E			
<u>7</u> miles <u>E</u> of <u>Deloraso</u>			
(distance) (direction) (nearest town)			
<b>WELL PURPOSE:</b> <u>Home</u>			
(home, irrigation, municipal, industrial)			
<b>WELL COMPLETION DATA:</b>			
(1) diameter (inches) <u>2"</u>			
(2) total depth (feet) <u>200'</u>			
(3) static water level (feet) <u>28'</u> <small>below above</small> top of ground.			
(4) casing <u>galv.</u> <u>190'</u> (material) (depth)			
<u>2"</u> (size) If telescope see back.			
(5) screen <u>10'</u> <u>190'</u> (length) (depth to top)			
<u>2"</u> <u>135"</u> (size) (material)			
(6) pump _____ (HP) (yield gpm)			
(type power)			
(7) electric log <u>no</u> (yes or no)			
(organization running log)			
(8) how well bottom plugged <u>wood plug</u>			
<b>DRILLERS REMARKS:</b>			

**RECEIVED**  
 FEB 10 1977

MISS. BD. OF WATER COMM

If well telescopes please sketch and show depths.

GROUND LEVEL

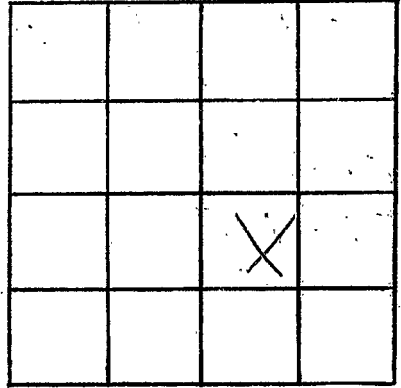

SECTION 40

Please indicate well location X.

ADDITIONAL INFORMATION

If more than one screen, show locations of each on sketch.