

Wilkinson
 C 2003
 6-6-77

61

MISSISSIPPI
 BOARD OF WATER COMMISSIONERS
 416 North State Street
 Jackson, Mississippi 39201

WATER WELL DRILLERS LOG

June 6 1977 Rever Miller Wilkinson
 date well completed firm name county well located

LANDOWNER:
Eugene Pritchard
Rt. Woodville
 (mailing address)

| description of formations encountered | from | to |
|---------------------------------------|-----------|-----------|
| <u>Clay</u> | <u>0</u> | <u>18</u> |
| <u>sand gravel</u> | <u>18</u> | <u>26</u> |
| <u>blue chalk</u> | <u>26</u> | <u>70</u> |
| <u>coarse sand</u> | <u>70</u> | <u>93</u> |

WELL LOCATION:
 sec. 14 T. 4 N. R. 1 E.
7 1/2 miles E-NE of Rosetta
 (distance) (direction) (nearest town)

WELL PURPOSE: Farm
 (home, irrigation, municipal, industrial)

- WELL COMPLETION DATA:
- (1) diameter (inches) 4'
 - (2) total depth (feet) 93
 - (3) static water level (feet) 12 above top of ground.
 - (4) casing plastic bottom
 (material) (depth)
 - if telescope see back.
 (size)
 - (5) screen 6' 87'
 (length) (depth to top)
 - 4" plastic
 (size) (material)
 - (6) pump 1/2 others
 (HP) (yield gpm)
 - elect
 (type power)
 - (7) electric log no
 (yes or no)
 - (organization running log)


(8) how well bottom plugged
wooden plug

DRILLERS REMARKS:

RECEIVED
 NOV - 9 1977

If well telescopes please sketch and show depths.

GROUND LEVEL

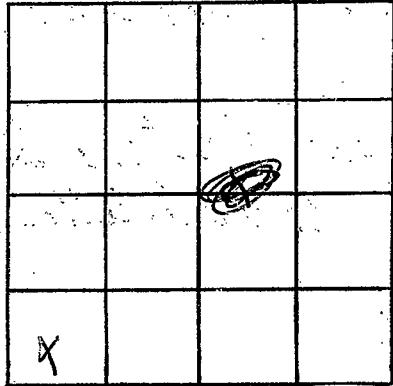

SECTION ¹⁴ ~~14~~

Please indicate well location X.

ADDITIONAL INFORMATION

If more than one screen, show locations of each on sketch.