

WILKINSON

C 2004

9-11-78

MISSISSIPPI BOARD OF WATER COMMISSIONERS
416 North State Street
Jackson, Mississippi 39201

WATER WELL DRILLERS LOG

Sept 11

1978 Reeves Well Ser

Wilkinson

date well completed

firm name

county well located


LANDOWNER:	description of formations encountered	from	to
B. J. Nettles	Clay	0	12
Rt 1 Crook (mailing address)	sand	12	45
WELL LOCATION:	blue Chalk	45	225
sec. 30 T 4 N R 1 W	fine sand	225	260
_____ miles _____ of _____ (distance) (direction) (nearest town)	Med. Coarse sand	260	280
WELL PURPOSE: <u>house</u> (home, irrigation, municipal, industrial)			
WELL COMPLETION DATA:			
(1) diameter (inches) <u>4"</u>			
(2) total depth (feet) <u>280'</u>			
(3) static water level (feet) <u>120</u> below top of ground.			
(4) casing <u>plastic bottom</u> (material) (depth)			
_____ if telescope see back. (size)			
(5) screen <u>10'</u> <u>270'</u> (length) (depth to top)			
_____ <u>plastic</u> (size) (material)			
(6) pump <u>1/4 hp</u> <u>18</u> (HP) (yield gpm)			
_____ <u>elect</u> (type power)			
(7) electric log <u>no</u> (yes or no)			
_____ <u>_____</u> (organization running log)			
(8) how well bottom plugged <u>wooden plug</u>			
DRILLERS REMARKS: <u>_____</u>			

RECEIVED
JAN 15 1978

MISS. BD. OF WATER COMMISSIONERS

If well telescopes please sketch and show depths.

GROUND LEVEL

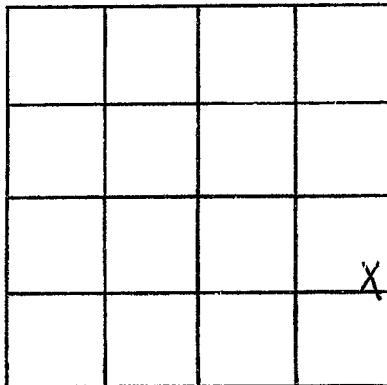

SECTION 30

Please indicate well location X.

ADDITIONAL INFORMATION

If more than one screen,
show locations of each on sketch.