

MISSISSIPPI DEPARTMENT OF NATURAL RESOURCES

Bureau of Land and Water Resources

Southport Mall

P.O. Box 10631

Jackson, Mississippi 39209

WATER WELL DRILLERS LOG

Wilkins
C 2005

5-14 1982 *Rayburn Dred. & Const. Co Wilkins*
date well completed firm name county well located

LANDOWNER:	description of formations encountered	from	to
<i>Adco Producing</i>			
<i>Natchez, ms</i> (mailing address)	<i>gumbo</i>	<i>8</i>	<i>145</i>
WELL LOCATION:	<i>sand</i>	<i>145</i>	<i>325</i>
sec. <i>18</i> T. <i>4</i> S. R. <i>1</i> E.			
<i>6</i> miles <i>W</i> of <i>Positta</i>			
(distance) (direction) (nearest town)			
WELL PURPOSE: (home, irrigation, municipal, industrial)			
WELL COMPLETION DATA:			
(1) diameter (inches) <i>3"</i>			
(2) total depth (feet) <i>325'</i>			
(3) static water level (feet) <i>100'</i> below top of ground.			
(4) casing <i>Blc</i> <i>325'</i> (material) (depth)			
<i>3"</i> (size) if telescope see back.			
(5) screen <i>20'</i> <i>305'</i> (length) (depth to top)			
<i>3"</i> <i>slotted Pipe</i> (size) (material)			
(6) pump <i>50</i> (HP) (yield gpm)			
(type power)			
(7) electric log <i>no</i> (yes or no)			
(organization running log)			
(8) how well bottom plugged <i>used plug</i>			
DRILLERS REMARKS:			

USA 18-10


DEPT. OF NATURAL RESOURCES
BUREAU OF LAND & WATER RESOURCES

MAY 21 1982

RECEIVED

If well telescopes please
sketch and show depths.

GROUND LEVEL

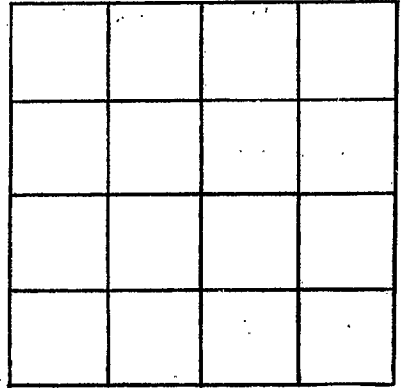

SECTION _____

Please indicate well location X.

ADDITIONAL INFORMATION

If more than one screen,
show locations of each on sketch.