

**MISSISSIPPI DEPARTMENT OF ENVIRONMENTAL QUALITY**

Office of Land and Water Resources

P. O. Box 10631  
Jackson, MS 39289-0631  
**WATER WELL DRILLERS LOG**

COUNTY WELL LOCATED <u>Wilkinson</u>	
WELL NUMBER <u>C-2012</u>	CODED
DATE WELL COMPLETED <u>7-13-01</u>	

PERMIT NUMBER <u>0-671</u>
NAME OF DRILLING FIRM <u>Daniel Boone</u>

NAME & MAILING ADDRESS OF LANDOWNER <u>Aundrea Laird</u>			
<u>1117 Crooked Creek Rd.</u>			
<u>Crosby MS</u>			
WELL LOCATION	SEC.	TOWNSHIP	RANGE
	<u>35</u>	<u>4</u>	<u>1</u>
DISTANCE	DIRECTION	NEAREST TOWN	
<u>11</u> Miles	<u>W</u>	of <u>Crosby</u>	
OTHER LANDMARK			
WELL PURPOSE: <input checked="" type="checkbox"/> Home Irrigation, <input type="checkbox"/> Municipal, <input type="checkbox"/> Industrial, <input type="checkbox"/> Fish Pond, etc.			

PUMP DATA		
PUMP TYPE (Circle One): <input checked="" type="radio"/> Submersible, <input type="radio"/> Turbine, <input type="radio"/> Jet <input type="radio"/> Flowing Well, Other (Describe) _____		
POWER TYPE (Circle One): <input checked="" type="radio"/> Electric, <input type="radio"/> Tractor, <input type="radio"/> Diesel, <input type="radio"/> Gasoline, <input type="radio"/> Butane, Other (Describe) _____ H/P <u>1</u>		
Pump Capacity (GPM) <u>12</u>	No. of Stages	Setting Depth <u>130</u> FT.
PUMP TEST		
Well yielded <u>16</u> GPM with		
a drawdown of <u>20</u> ft.		
after <u>8</u> hours of pumping		

WELL DATA		
Well Depth <u>242</u>	Casing Diameter (In.) <u>4"</u>	Casing Length (Ft.) <u>222</u>
Type of Casing <u>PVC</u>	Hole Depth <u>245</u>	Depth to Static Water Level <u>98</u>
TYPE OF COMPLETION: (Circle One or More): <input checked="" type="radio"/> Gravel Packed, <input type="radio"/> Underreamed, <input type="radio"/> Telescoped, <input type="radio"/> Natural Development, <input type="radio"/> Open Hole, <input type="radio"/> Other (Describe): _____		
WELL GROUTED TO A DEPTH OF <u>9</u> FEET Type Grout (circle one): <input checked="" type="radio"/> Cement, <input type="radio"/> Bentonite, or Mix		

LOG DATA	
TYPE OF LOG RUN (Circle One): <input type="radio"/> Electric, <input type="radio"/> Gamma Ray, <input type="radio"/> Density, <input type="radio"/> Sonic, <input type="radio"/> Neutron, Other (Describe) _____	
Name of Organization Running Log	

SCREEN DATA		
Diameter - Inches <u>4"</u>	Length - Feet <u>20'</u>	Slot Size - Inches <u>.008</u>
Screen Type <u>PVC Sch. 40</u>	Depth to Bottom - Feet <u>3'</u>	


GEOLOGIC DATA (Office Use Only)			
Surface Elev.	Geologic Unit	Unit Thickness	Depth to Top
Subs. SWL	Date	Analysis	Aquifer Test
Driller's Remarks			
Top of Lap Pipe or Reduction in Casing			
FEET: IF TELESCOPED OR MORE THAN ONE SCREEN, USE BACK PAGE			

DESCRIPTION OF FORMATIONS ENCOUNTERED	FROM	TO
<u>Clay</u>	<u>0</u>	<u>9</u>
<u>Sand</u>	<u>9</u>	<u>45</u>
<u>Yazoo Clay</u>	<u>45</u>	<u>200</u>
<u>Sand</u>	<u>200</u>	<u>242</u>
<u>Clay</u>	<u>242</u>	<u>245</u>

FORMATIONS (Continued)	FROM	TO
REC'D AUG 31 2001		
IF MORE SPACE IS NEEDED, USE BACK		

If well telescopes please  
sketch and show depths.

GROUND LEVEL

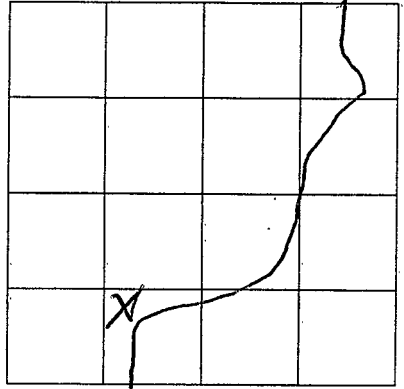

SECTION 35

Please indicate well location X.

ADDITIONAL INFORMATION

If more than one screen,  
show location of each on sketch.