

MISSISSIPPI DEPARTMENT OF NATURAL RESOURCES

Bureau of Land and Water Resources

Southport Mall

P.O. Box 10631

**JUDEB**


Jackson, Mississippi 39209

WATER WELL DRILLERS LOG

W. L. KENSON  
D  
3/18/81

31-18 1981 Rayhorn Drilling & Const. Co. Wilkenson  
 date well completed firm name county well located


LANDOWNER:	description of formations encountered:	from	to
<u>B. G. Fortenberry Drill. Co.</u>			
<u>Nitche, MS</u> (mailing address)	<u>Red clay</u>	<u>2</u>	<u>90</u>
	<u>Shale</u>	<u>90</u>	<u>170</u>
	<u>Coarse Sand</u>	<u>170</u>	<u>235</u>
	<u>Shale</u>	<u>235</u>	<u>275</u>
	<u>Sand</u> <b>JUDEB</b>	<u>275</u>	<u>310</u>
<b>WELL LOCATION:</b> sec <u>23</u> T <u>4N</u> R <u>1E</u> S W <u>3</u> miles <u>W</u> of <u>Roetta</u> (distance) (direction) (nearest town)			
<b>WELL PURPOSE:</b> <u>Supply</u> (home, irrigation, municipal, industrial)			
<b>WELL COMPLETION DATA:</b> (1) diameter (inches) <u>16 7/8" N 81660 1/2"</u> (2) total depth (feet) <u>310'</u> (3) static water level (feet) <u>100'</u> below above top of ground. (4) casing <u>Blk</u> <u>310'</u> (material) (depth) <u>3"</u> if telescope see back. (size) (5) screen <u>20'</u> (length) (depth to top) (size) (material) (6) pump <u>60</u> (HP) (yield gpm) (type power) (7) electric log <u>no</u> (yes or no) (organization running log) (8) how well bottom plugged <u>Wood Plug</u>			

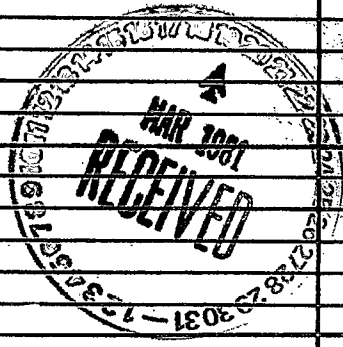

DRILLERS REMARKS:

If well telescopes please sketch and show depths.

GROUND LEVEL

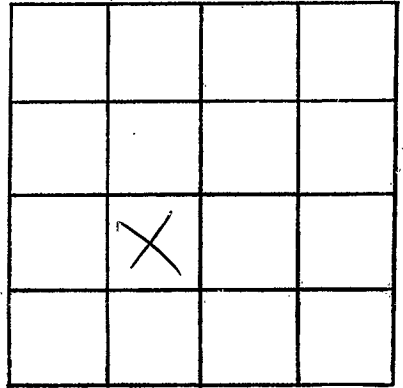

SECTION 23

Please indicate well location X.

ADDITIONAL INFORMATION

If more than one screen,  
show locations of each on sketch.