

CODED

WILKINSON
D
5-68

MISSISSIPPI
BOARD OF WATER COMMISSIONERS
416 North State Street
Jackson, Mississippi 39201

Elev: UNKNOWN

WATER WELL DRILLERS LOG

MAY 23 1968
date well completed

Central Const. Co.
firm name

Wilkinson
county well located

LANDOWNER: U.S.A.

description of formations encountered from to

New & Hughes
(mailing address)

SHALE 0 110
SHALE & SAND 110 240
SAND 240 365

WELL LOCATION:
sec 26 T 4 N R 1 E
4 miles SW of ROSETTA
(distance) (direction) (nearest town)

WELL PURPOSE: SUPPLY
(home, irrigation, municipal, industrial)

WELL COMPLETION DATA:

- (1) diameter (inches) 3
- (2) total depth (feet) 365'
- (3) static water level (feet) 130 below top of ground.
- (4) casing STEEL, 355', 3" (material) (depth) (size) if telescope see back.
- (5) screen 10', 355' (length) (depth to top) 3", SLOTTED PIPE (size) (material)
- (6) pump AIR (HP) (yield gpm) BUTANE (type power)
- (7) electric log NO (yes or no)

(organization running log)


(8) how well bottom plugged ADDLED CLAY

DRILLERS REMARKS:

MAY 23 1968
MISS. BOARD OF WATER COMMISSIONERS

If well telescopes please sketch and show depths.

GROUND LEVEL

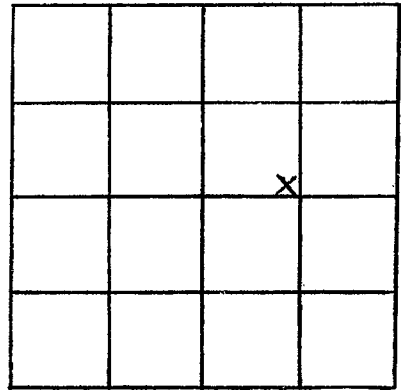

S
SECTION 26

Please indicate well location X.

ADDITIONAL INFORMATION

SOUTH LINE 2396 FT.
WEST LINE 1627 FT.

If more than one screen,
show locations of each on sketch.