

WILK.

D2

12-7-62

Date: 12.7, 1962, Driller: Hoerrig Pump Co County Franklin  
(Name)

CODED

WATER WELL DRILLERS LOG

CODED

WILKINSON

(1) Owner of Land: post office Keller  
(Name)  
Rosetter Miss  
(Address)

(2) Location: 1/4, 1/4, Sec. 13 T4N R1E  
city miles 1.1 of Rosetter  
(distance) (direction) (Nearest Town)

(3) Topography: \_\_\_\_\_  
(Hilly) (Flat) (Level)

(4) Purpose of Well: Domestic  
(Domestic Irrigation  
 Municipal, Industrial, Other)

Description & Color of Materials  
 Sand, Clay, Red Clay, Shell, etc.

Thick-  
ness  
Feet

Depth  
Feet

Clay  
Sand

1  
574

CODED


Information upon completion of well:

- (1) Diameter 4 3/4 inches.
- (2) Total Depth 194 feet.
- (3) Water Level 55 feet below top of ground.
- (4) Cased to 189, Size 2"
- (5) Screen: Size 2", Length 5'
- (6) Were any formations sealed against pollution?  
yes,  no.

If YES depth of formation \_\_\_\_\_

Why \_\_\_\_\_

Drillers Remarks: \_\_\_\_\_

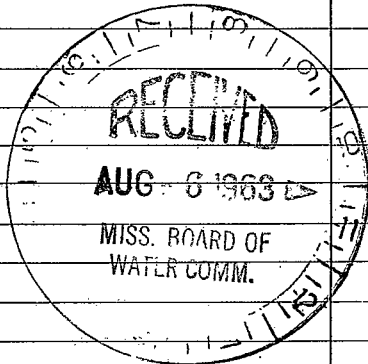

(Use Back Side)

Well No.

