

WILKINSON
D 9
6-10-69

MISSISSIPPI
BOARD OF WATER COMMISSIONERS
416 North State Street
Jackson, Mississippi 39201

CODED

WATER WELL DRILLERS LOG

June 10 1969 Reems Well Drilling Co. Wilkinson
date well completed firm name county well located

LANDOWNER: Richard
Haney
RT-1, Crasby -
(mailing address)

description of formations encountered	from	to
Red clay	0	12
Red stick chalk	12	21
Red sand & gravel	21	45
Red gravel & sand	45	102

WELL LOCATION:
sec 38 T 4 N R 1 E
4 miles W of Crasby
(distance) (direction) (nearest town)

WELL PURPOSE: Home
(home, irrigation, municipal, industrial)

WELL COMPLETION DATA:

(1) diameter (inches) 4"

(2) total depth (feet) 102

(3) static water level (feet) 67 below top of ground.

(4) casing Plastic, Bottom
(material) (depth)

(size) if telescope see back.

(5) screen 6" 96'
(length) (depth to top)

14" Plastic
(size) (material)

(6) pump 5.5 12
(HP) (yield gpm)

Elect
(type power)

(7) electric log no
(yes or no)

(organization running log)

CODED

(8) how well bottom plugged Wooden plug


DRILLERS REMARKS: New bore

AUG 25 1969

MISSISSIPPI
STATE
BOARD OF
WATER COMMISSIONERS

If well telescopes please sketch and show depths.

GROUND LEVEL

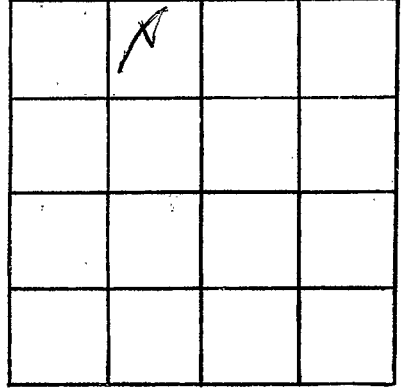

SECTION 38

Please indicate well location X.

ADDITIONAL INFORMATION

If more than one screen,
show locations of each on sketch.