

Wilkinson  
D11  
10-10-69

MISSISSIPPI  
BOARD OF WATER COMMISSIONERS  
416 North State Street  
Jackson, Mississippi 39201

**CODED**

WATER WELL DRILLERS LOG

Wilkinson  
County

Oct 10 1969 Gen Newswell Pump Co firm name Wilkinson county well located  
date well completed

LANDOWNER: Wilkinson  
Foreman  
Crosby, Miss  
(mailing address)

description of formations encountered	from	to
<u>red sandy clay</u>	<u>0</u>	<u>16</u>
<u>white chalk</u>	<u>0</u>	<u>92</u>
<u>residual clay</u>	<u>92</u>	<u>122</u>

WELL LOCATION:  
sec. 27 T 4 N R 1 E  
2 1/2 miles NW of Crosby  
(distance) (direction) (nearest town)

WELL PURPOSE: Home  
(home, irrigation, municipal, industrial)

WELL COMPLETION DATA:  
(1) diameter (inches) 4"  
(2) total depth (feet) 122  
(3) static water level (feet) 92 below above-  
top of ground.  
(4) casing Plastic Ballam  
(material) (depth)  
         if telescope see back.  
(size)  
(5) screen 6' 116'  
(length) (depth to top)  
4" Plastic  
(size) (material)  
(6) pump 1/2 Sub-10  
(HP) (yield gpm)  
Electric  
(type power)  
(7) electric log No  
(yes or no)  
          
(organization running log)

(8) how well bottom plugged  
wood plug


DRILLERS REMARKS:  
old 2" well box

DEC 31 1969

MISSISSIPPI  
BOARD OF WATER COMMISSIONERS

If well telescopes please sketch and show depths.

GROUND LEVEL

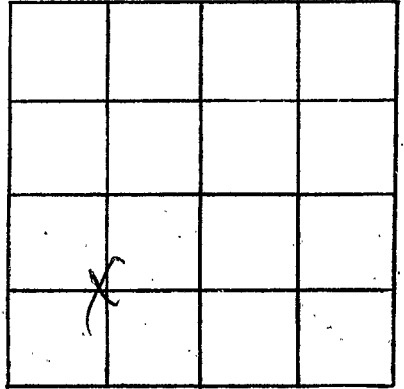

SECTION 27

Please indicate well location X.

ADDITIONAL INFORMATION

If more than one screen, show locations of each on sketch.