

Wilkinson
D 12
1-17-70

MISSISSIPPI
 BOARD OF WATER COMMISSIONERS
 416 North State Street
 Jackson, Mississippi 39201

CODED

WATER WELL DRILLERS LOG

1-17 1970 Griner Water Well Co. Wilkinson
 date well completed firm name county well located

LANDOWNER:
Gordon Rymer
Rosetta, Miss.
 (mailing address)

description of formations encountered	from	to
<u>Top soil</u>		
<u>Red clay</u>	<u>02</u>	<u>10</u>
<u>Chalk</u>	<u>10</u>	<u>50</u>
<u>fine sand</u>	<u>50</u>	<u>53</u>
<u>Chalk</u>	<u>53</u>	<u>126</u>
<u>Sand</u>	<u>126</u>	<u>175</u>

WELL LOCATION:
 sec. 21 T 4 N R 1 E
0 miles In town of Rosetta
 (distance) (direction) (nearest town)

WELL PURPOSE: Home
 (home, irrigation, municipal, industrial)

- WELL COMPLETION DATA:
- (1) diameter (inches) 2"
 - (2) total depth (feet) 175'
 - (3) static water level (feet) 65 ^{below}/_{above} top of ground.
 - (4) casing Ally, 168'
 (material) (depth)
2" If telescope see back.
 (size)
 - (5) screen 5', 168'
 (length) (depth to top)
2", SS
 (size) (material)
 - (6) pump 1 7
 (HP) (yield gpm)
elec
 (type power)
 - (7) electric log no
 (yes or no)
- (organization running log)

JAN 23 1970


MISS. BD. OF
 WATER COMM.

(8) how well bottom plugged was plg

DRILLERS REMARKS:

If well telescopes please sketch and show depths.

GROUND LEVEL

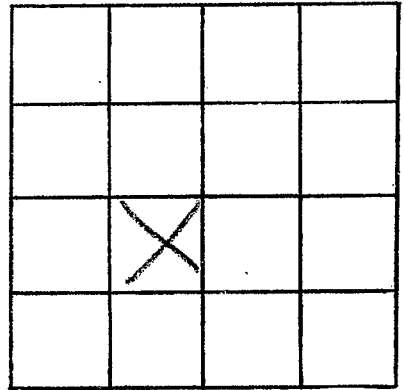

SECTION 21

Please indicate well location X.

ADDITIONAL INFORMATION

If more than one screen, show locations of each on sketch.