

WILKINSON

D14

6-6-70

MISSISSIPPI BOARD OF WATER COMMISSIONERS
416 North State Street
Jackson, Mississippi 39201

CODED

WATER WELL DRILLERS LOG

June 6 1970 date well completed
Chester Keener Wilkinson firm name
county well located

LANDOWNER: H. Ashley

At-1, Crashey

(mailing address)

WELL LOCATION:

38 sec T-4 N R-1 E
4 miles W of Crashey
(distance) (direction) (nearest town)

WELL PURPOSE: Drain
(home, irrigation, municipal, industrial)

WELL COMPLETION DATA:

- (1) diameter (inches) 4"
- (2) total depth (feet) 103
- (3) static water level (feet) 62 below above top of ground.
- (4) casing Plastic Baller
(material) (depth)
- (5) screen 6' 97'
(length) (depth to top)
- (6) pump 1/2 1 1/2
(HP) (yield gpm)
- (7) electric log NO
(yes or no)

(organization running log)

(8) how well bottom plugged
wooden plug

DRILLERS REMARKS:
old well hole

description of formations encountered

from to

white clay	0	33
fine white sand	33	94
medium coarse sand	94	103


CODED

OCT 14 1970

MISS. BD. OF WATER COMM.

If well telescopes please sketch and show depths.

GROUND LEVEL

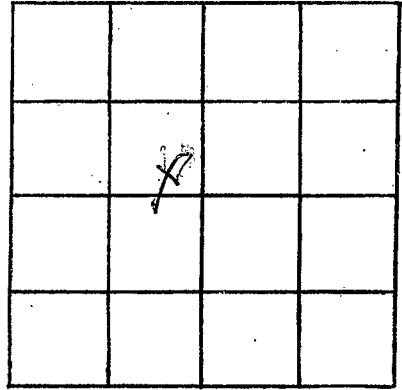

SECTION 38

Please indicate well location X.

ADDITIONAL INFORMATION

If more than one screen,
show locations of each on sketch.