

WILKINSON
 D 15
 8-15-70

MISSISSIPPI
 BOARD OF WATER COMMISSIONERS
 416 North State Street
 Jackson, Mississippi 39201

CODED

WATER WELL DRILLERS LOG

Aug 15 1970 date well completed
 Chester Koenig firm name
 Wilkinson county well located

LANDOWNER: Willie Hooper
 R.F. Crasby
 (mailing address)

description of formations encountered	from	to
Clay	0	22
Sand gravel	22	38
white chalk	38	91
fine white sand	91	112
Sand	112	122

WELL LOCATION:
 sec 25 T 4 N R 1 E
 3 1/2 miles W of Crasby
 (distance) (direction) (nearest town)

WELL PURPOSE: Harvest
 (home, irrigation, municipal, industrial)

- WELL COMPLETION DATA:
- (1) diameter (inches) 4 1/2"
 - (2) total depth (feet) 122
 - (3) static water level (feet) 95 below top of ground
 - (4) casing Plastic bottom (material) (depth)
 - (size) If telescope see back.
 - (5) screen 6' 116' (length) (depth to top)
 4" Plastic (size) (material)
 - (6) pump 1/2 HP 12 (HP) (yield gpm)
 Electric (type power)
 - (7) electric log No (yes or no)
 - (organization running log)

CODED

(8) how well bottom plugged
 wooden plug


DRILLER'S REMARKS:
 2nd 2" well head

OCT 14 1970

MISS. DD. OF
 WATER COMM.

If well telescopes please sketch and show depths.

GROUND LEVEL

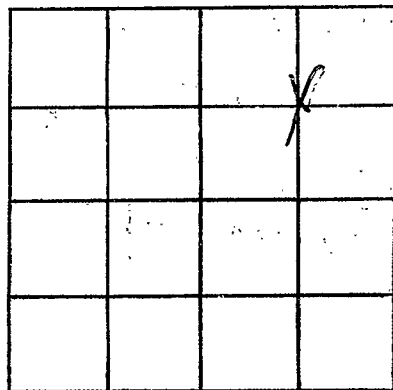

SECTION 35

Please indicate well location X.

ADDITIONAL INFORMATION

If more than one screen,
show locations of each on sketch.