

WILKINSON
D-16
7-22-71

MISSISSIPPI
BOARD OF WATER COMMISSIONERS
416 North State Street
Jackson, Mississippi 39201

CODED

WATER WELL DRILLERS LOG

July 22 1971 date well completed
Chester Keener firm name
Wilkinson county well located

LANDOWNER: John Murray Rt. 1, Box 16-A Coashy (mailing address)	description of formations encountered	from to
	clay	0-13
	white sand	13-27
	hard shale	27-72
	blue chalk	72-112
	coarse white sand	112-133
<p>WELL LOCATION: sec. 38 T. 4 N. R. 1 E 1/4 miles W Coashy (distance) (direction) (nearest town)</p> <p>WELL PURPOSE: Home (home, irrigation, municipal, industrial)</p> <p>WELL COMPLETION DATA:</p> <p>(1) diameter (inches) 4 1/2"</p> <p>(2) total depth (feet) 133</p> <p>(3) static water level (feet) 70 below top of ground.</p> <p>(4) casing <u>plastic bottom</u> (material) (depth)</p> <p>(size) if telescope see back.</p> <p>(5) screen <u>6" 127</u> (length) (depth to top)</p> <p><u>4" plastic</u> (size) (material)</p> <p>(6) pump <u>1/2 sub 10</u> (HP) (yield gpm)</p> <p><u>elect</u> (type power)</p> <p>(7) electric log <u>no</u> (yes or no)</p> <p>(organization running log)</p> <p>(8) how well bottom plugged <u>wooden plug</u></p> <p>DRILLERS REMARKS: old 7" well bad</p>		


CODED

SEP 20 1971

MISS. BOARD OF WATER COMMISSIONERS

If well telescopes please sketch and show depths.

GROUND LEVEL

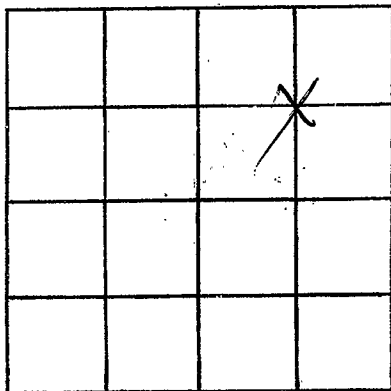

SECTION 38

Please indicate well location X.

ADDITIONAL INFORMATION

If more than one screen, show locations of each on sketch.