

WILKINSON  
D-17  
7-24-71

MISSISSIPPI  
 BOARD OF WATER COMMISSIONERS  
 416 North State Street  
 Jackson, Mississippi 39201

WATER WELL DRILLERS LOG

**CODED**

July 24 1971 Chester Kerner Wilkinson  
 date well completed firm name county well located

LANDOWNER: Paul Foreman  
Rt 1, Crasby  
 (mailing address)

description of formations encountered	from	to
<u>top soil</u>	<u>0</u>	<u>4</u>
<u>white sand &amp; gravel</u>	<u>4</u>	<u>22</u>
<u>blue chalk</u>	<u>22</u>	<u>140</u>
<u>fine white sand</u>	<u>140</u>	<u>153</u>
<u>crushed white sand</u>	<u>153</u>	<u>166</u>

WELL LOCATION:  
 sec 21 T 4 N R 1 E  
In Rosetta  
 (distance) miles (direction) of (nearest town)

WELL PURPOSE: Home  
 (home, irrigation, municipal, industrial)

- WELL COMPLETION DATA:
- (1) diameter (inches) 4"
  - (2) total depth (feet) 166
  - (3) static water level (feet) 20 below above top of ground.
  - (4) casing Plast Batten  
 (material) (depth)
  - (size) if telescope see back.
  - (5) screen 6' 160'  
 (length) (depth to top)  
Plast  
 (size) (material)
  - (6) pump 4 sub 15  
 (HP) (yield gpm)  
elect  
 (type power)
  - (7) electric log no  
 (yes or no)
  - (organization running log)

**CODED**

(8) how well bottom plugged wood chips


DRILLERS REMARKS: old 2" well had

SEP 17 1971

MISS. BD. OF  
 WATER COMMISSIONERS

If well telescopes please sketch and show depths.

GROUND LEVEL

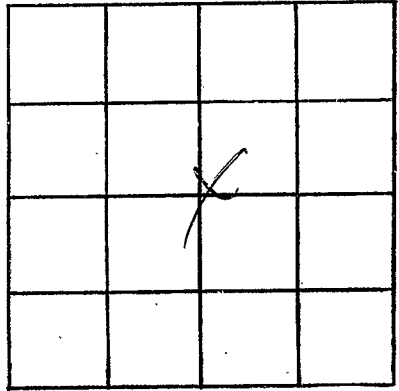

SECTION 24

Please indicate well location X.

ADDITIONAL INFORMATION

If more than one screen,  
show locations of each on sketch.