

WILKINSON  
D19  
4-19-74

MISSISSIPPI  
BOARD OF WATER COMMISSIONERS  
416 North State Street  
Jackson, Mississippi 39201

CODED

WATER WELL DRILLERS LOG

April 19 1974 Chester Keene Wilkinson  
date well completed firm name county well located


LANDOWNER:	description of formations encountered	from	to
Mr. Douglas Joseph	Sandy clay	0	70
Rt. Crasley (mailing address)	white chert gravel	20	52
	coarse sand	52	101
<b>WELL LOCATION:</b>			
sec. 32 T 4 N R 1 E			
1 miles NW of Crasley (distance) (direction) (nearest town)			
<b>WELL PURPOSE:</b> (home, irrigation, municipal, industrial)			
<b>WELL COMPLETION DATA:</b>			
(1) diameter (inches) 4 1/2			
(2) total depth (feet) 101			
(3) static water level (feet) 47 below top of ground.			
(4) casing Post Bottom (material) (depth)			
(size) If telescope see back.			
(5) screen 16 95 (length) (depth to top)			
16" Plast (size) (material)			
(6) pump 1/2 sub 15 (HP) (yield gpm)			
ELECT (type power)			
(7) electric log No (yes or no)			
(organization running log)			
(8) how well bottom plugged			
no plug			
<b>DRILLERS REMARKS:</b>			
old well pumped sand			

RECEIVED  
OCT 31 1974

MISS. BD. OF WATER COMMISSIONERS

If well telescopes please sketch and show depths.

GROUND LEVEL

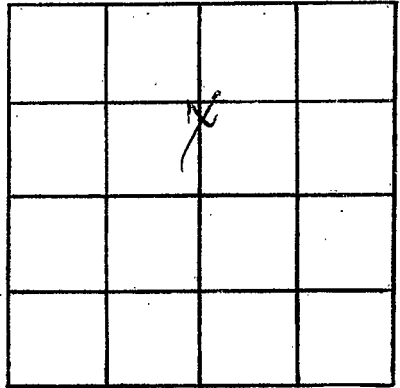

SECTION 32

Please indicate well location X.

ADDITIONAL INFORMATION

If more than one screen, show locations of each on sketch.