

WILKINSON
D20
8-8-74

MISSISSIPPI
BOARD OF WATER COMMISSIONERS
416 North State Street
Jackson, Mississippi 39201

CODED

WATER WELL DRILLERS LOG

Aug 8 1974 date well completed
Chester Reeves Wilkinson firm name
Wilkinson county well located

LANDOWNER: EL. Foreman
Rt. 1
Coashy -
(mailing address)

WELL LOCATION:
sec. 24 T 4 N R 1 E
in Rosetta
(distance) miles (direction) (nearest town)

WELL PURPOSE: Home
(home, irrigation, municipal, industrial)

- WELL COMPLETION DATA:
- (1) diameter (inches) 4"
 - (2) total depth (feet) 187
 - (3) static water level (feet) 92 below top of ground.
 - (4) casing plastic bottom
(material) (depth)
 - (5) screen 6' 141
(length) (depth to top)
4" plastic
(size) (material)
 - (6) pump old pump
(HP) (yield/gpm)
sewer
(type power)
 - (7) electric log (yes or no) no
(organization running log)
 - (8) how well bottom logged woodruff


description of formations encountered	from	to
clay sand	0	14
blue clay	14	47
fine sand	47	48
blue chalk	48	106
fine sand	106	116
blue chalk with fine sand	116	165
coarse sand	165	187

DRILLERS REMARKS:
old 2" well had

REGISTERED
OCT 31 1974

If well telescopes please sketch and show depths.

GROUND LEVEL

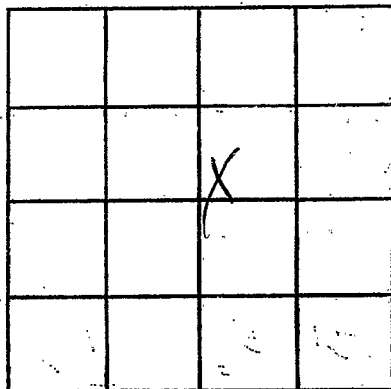

SECTION 21

Please indicate well location X.

ADDITIONAL INFORMATION

If more than one screen, show locations of each on sketch.