

WILKINSON  
D 22  
4-18-74

MISSISSIPPI  
BOARD OF WATER COMMISSIONERS  
416 North State Street  
Jackson, Mississippi 39201

CODED

CODED

WATER WELL DRILLERS LOG

April 18 1974 Chester Lewis Wilkinson  
date well completed firm name county well located

LANDOWNER	description of formations encountered	from	to
Jesse Lee Arnold	clay	0	12
RFI, Crosby (mailing address)	sand gravel	12	51
	white sand	51	93
<p>WELL LOCATION:</p> <p>sec. <u>43</u> T <u>4</u> N R <u>1</u> E <sup>D</sup> <sub>14 A</sub></p> <p><u>4</u> miles <u>west</u> of <u>Route</u> (distance) (direction) (nearest town)</p> <p>WELL PURPOSE: <u>Home</u> (home, irrigation, municipal, industrial)</p> <p>WELL COMPLETION DATA:</p> <p>(1) diameter (inches) <u>4"</u></p> <p>(2) total depth (feet) <u>93</u></p> <p>(3) static water level (feet) <u>60</u> above-top of ground.</p> <p>(4) casing <u>Plast. Bottom</u> (material) (depth)</p> <p>(size) If telescope see back.</p> <p>(5) screen <u>6'</u> <u>87'</u> (length) (depth to top)</p> <p><u>4"</u> <u>Plast</u> (size) (material)</p> <p>(6) pump <u>1/2 HP</u> <u>12</u> (HP) (yield gpm)</p> <p><u>Plast</u> (type power)</p> <p>(7) electric log <u>NO</u> (yes or no)</p> <p>(organization running log)</p> <p>(8) how well bottom plugged <u>wooden plug</u></p> <p>DRILLERS REMARKS: <u>New house site</u></p>			

CODED


RECEIVED

FEB 18 1975

MISS. BD. OF WATER COMM

If well telescopes please sketch and show depths.

GROUND LEVEL

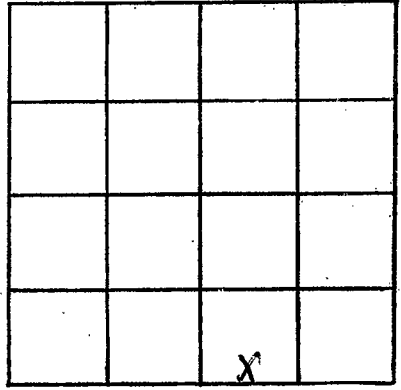

SECTION 43

Please indicate well location X.

ADDITIONAL INFORMATION

Lined area for additional information.

If more than one screen, show locations of each on sketch.