

Wilkinson
D 23
4-3-75

CODED

MISSISSIPPI
BOARD OF WATER COMMISSIONERS
416 North State Street
Jackson, Mississippi 39201

WATER WELL DRILLERS LOG

April 3 1975 *Chet News* ²⁸¹ *Wilkinson*
date well completed firm name county well located

LANDOWNER:
M. R. Greer
Rosetta Miss
(mailing address)

| description of formations encountered | from | to |
|---------------------------------------|------------|------------|
| <i>sandy clay</i> | <i>0</i> | <i>15</i> |
| <i>blue chalk</i> | <i>15</i> | <i>130</i> |
| <i>white sand</i> | <i>130</i> | <i>135</i> |
| <i>white & blue chalk</i> | <i>135</i> | <i>164</i> |
| <i>coarse white sand</i> | <i>164</i> | <i>182</i> |

WELL LOCATION:
sec. *21* T *4* N R *1* E
in town *Rosetta*
(distance) (direction) (nearest town)

WELL PURPOSE: *home*
(home, irrigation, municipal, industrial)

- WELL COMPLETION DATA:
- (1) diameter (inches) *4"*
 - (2) total depth (feet) *182*
 - (3) static water level (feet) *65*
top of ground *below*
 - (4) casing *plastic bottom*
(material) (depth)
 - If telescope see back.
(size)
 - (5) screen *6* , *176*
(length) (depth to top)
 - 4* , *plastic*
(size) (material)
 - (6) pump *1/2 Sub* *10*
(HP) (yield gpm)
 - elect*
(type power)
 - (7) electric log *no*
(yes or no)

(organization running log)


(8) how well bottom plugged *wooden plug*

DRILLERS REMARKS:

MAY 8 1975
MISS. BD. OF WATER COMMISSIONERS

If well telescopes please sketch and show depths.

GROUND LEVEL

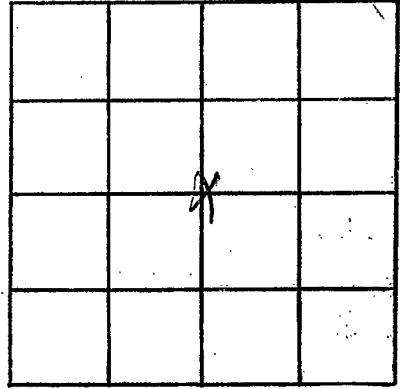

SECTION 21

Please indicate well location X.

ADDITIONAL INFORMATION

Lined area for additional information.

If more than one screen, show locations of each on sketch.