

MISSISSIPPI DEPARTMENT OF NATURAL RESOURCES

Bureau of Land and Water Resources

Southport Mall

P.O. Box 10631

Jackson, Mississippi 39209

WATER WELL DRILLERS LOG

CODED

WILKINSON  
D 32  
4-9-81

4-9-81 date well completed 19 81 Rayburn Drill & Const. Co. firm name Wilkinson county well located


285' S 8330' W of NE Cor.

LANDOWNER:  
Ray & Hughes Drill. Co.  
Natchez, MS.  
(mailing address)  
WELL LOCATION:  
sec. 23 T 4 N R 1 E S  
4 miles W of Rosetta  
(distance) (direction) (nearest town)  
WELL PURPOSE:  
(home, irrigation, municipal, industrial)

description of formations encountered	from	to
Top soil	0	2
Clay	2	80
Shale	80	140
Sand	140	230
Shale	230	245
Sand	245	385

WELL COMPLETION DATA:  
(1) diameter (inches) 3"  
(2) total depth (feet) 385'  
(3) static water level (feet) 85' below top of ground.  
(4) casing Blk 385' (material) (depth) 3" (size) if telescope see back.  
(5) screen (length) (depth to top) (size) (material)  
(6) pump 10 GPM (HP) (yield gpm) (type power)  
(7) electric log NO (yes or no) (organization running log)  
(8) how well bottom plugged wood plug


Stalled pipe 365' - 385'

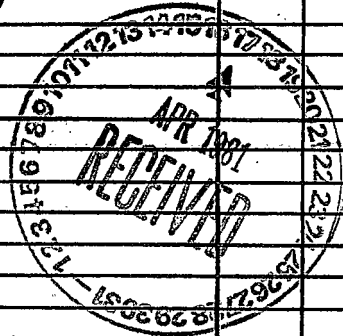

DRILLERS REMARKS:

If well telescopes please sketch and show depths.

GROUND LEVEL

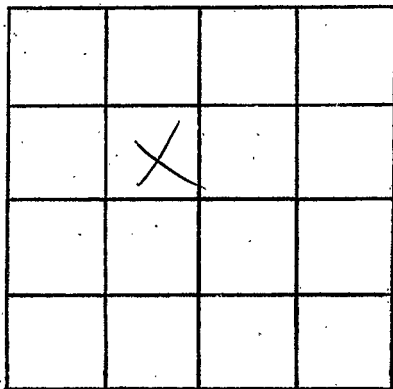

SECTION 23

Please indicate well location X.

ADDITIONAL INFORMATION

If more than one screen, show locations of each on sketch.