

MISSISSIPPI DEPARTMENT OF NATURAL RESOURCES

Bureau of Land and Water Resources

Southport Mall

P.O. Box 10631

CODED

Jackson, Mississippi 39209

WATER WELL DRILLERS LOG

Wilkinson
D33
6-22-81

6-22 date well completed Rayson Drilling Co firm name Wilkinson county well located

LANDOWNER:
D & D Drilling Company
Natcher, ms
 (mailing address)

description of formations encountered	from	to
<u>Chalk</u>	<u>0</u>	<u>25</u>
<u>Gumbo</u>	<u>25</u>	<u>105</u>
<u>shale</u>	<u>105</u>	<u>200</u>
<u>stratified sand & gumbo</u>	<u>200</u>	<u>250</u>
<u>sand</u>	<u>250</u>	<u>305</u>

WELL LOCATION:
 sec. 27 T 4 N R 2 E S 1 W
4 miles NW of Crosby
 (distance) (direction) (nearest town)

2133' N + 1489' W of

WELL PURPOSE:
 (home, irrigation, municipal, industrial)


SE Cor of Sec. 27

- WELL COMPLETION DATA:
- (1) diameter (inches) 3"
 - (2) total depth (feet) 305'
 - (3) static water level (feet) _____ below/above top of ground.
 - (4) casing galv. 305'
 (material) (depth)
3"
 (size) If telescope see back.
 - (5) screen 20' 285'
 (length) (depth to top)
2" Slotted Pipe
 (size) (material)
 - (6) pump _____ 50 gpm
 (HP) (yield gpm)

 (type power)
 - (7) electric log no
 (yes or no)

 (organization running log)
 - (8) how well bottom plugged Wood Plug


CODED

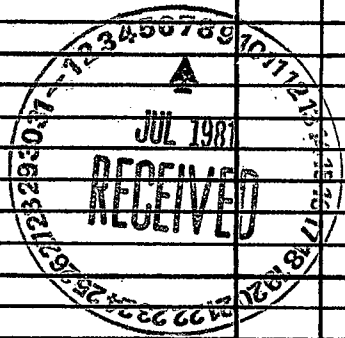

DRILLERS REMARKS:

If well telescopes please
sketch and show depths.

GROUND LEVEL

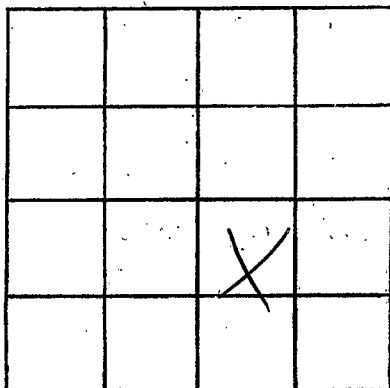

SECTION *27*

Please indicate well location X.

ADDITIONAL INFORMATION

If more than one screen,
show locations of each on sketch.