

MISSISSIPPI DEPARTMENT OF NATURAL RESOURCES

Bureau of Land and Water Resources

Southport Mall

P.O. Box 10631

Jackson, Mississippi 39209

WATER WELL DRILLERS LOG

CODED


<i>WILKINSON</i>
<i>D 34</i>
<i>10-19-81</i>

10-19 19*81* *Rayhorn Drill & Const. Co. Wilkinson*
 date well completed firm name county well located

LANDOWNER:	description of formations encountered	from	to
<i>D & D Drill Co.</i>	<i>Top soil</i>	<i>0</i>	<i>2</i>
<i>Natches, MS</i> (mailing address)	<i>Red gravel</i>	<i>2</i>	<i>60</i>
WELL LOCATION: sec. <i>38</i> T. <i>4</i> N R. <i>1</i> E S W	<i>Humbo</i>	<i>60</i>	<i>120</i>
<i>1</i> mile miles <i>S</i> of <i>Rosetta</i> (distance) (direction) (nearest town)	<i>Streak sand & shale</i>	<i>120</i>	<i>250</i>
WELL PURPOSE: (home, irrigation, municipal, industrial)	<i>Shale</i>	<i>250</i>	<i>300</i>
WELL COMPLETION DATA:	<i>Sand</i>	<i>300</i>	<i>357</i>
(1) diameter (inches) <i>3"</i>	<i>311' N + 488' E of</i> <i>SW Cor NW 1/4</i> CODE		
(2) total depth (feet) <i>357'</i>			
(3) static water level (feet) <i>90'</i> below above top of ground.			
(4) casing <i>BWC</i> <i>337'</i> (material) (depth)			
<i>3"</i> (size) if telescope see back.			
(5) screen <i>20'</i> <i>337'</i> (length) (depth to top)			
<i>3"</i> <i>slotted Pipe</i> (size) (material)			
(6) pump <i>—</i> <i>50 GPM</i> (HP) (yield gpm)			
(type power)			
(7) electric log <i>no</i> (yes or no)			
(organization running log)			
(8) how well bottom plugged <i>wood Plug</i>			
DRILLERS REMARKS:	<i>Rec'd 2/4/81</i> <i>10-21-81</i>		

If well telescopes please sketch and show depths.

GROUND LEVEL

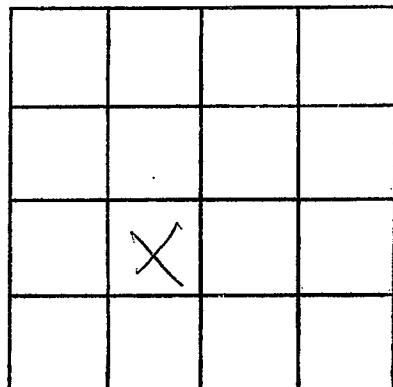

SECTION 28

Please indicate well location X.

ADDITIONAL INFORMATION

If more than one screen,
show locations of each on sketch.