

MISSISSIPPI DEPARTMENT OF NATURAL RESOURCES

Bureau of Land and Water Resources

Southport Mall

P.O. Box 10631

Jackson, Mississippi 39209

WATER WELL DRILLERS LOG

CODET

WILKINSON
D 35
10-20-81


10-20
date well completed

Rayhorn Drilling & Land Co. Wilkinson
firm name county well located

LANDOWNER:	description of formations encountered	from	to
D & D Drilling Natchez MS 39120 (mailing address)	Top soil Shale sand	0 2 275	2 225 315
WELL LOCATION: sec 28 T 4 N R 1 E S W 1 mi miles of Rossette (distance) (direction) (nearest town)	381' N & 488' E of SW		
WELL PURPOSE: (home, irrigation, municipal, industrial)	Cor NW NW		
WELL COMPLETION DATA:			
(1) diameter (inches) 2"			
(2) total depth (feet) 315'			
(3) static water level (feet) 90' below top of ground		CODED	
(4) casing (material) (depth) 295'			
3" (size) if telescope see back.			
(5) screen (length) (depth to top) 20' 295'			
3" (size) slotted pipe (material)			
(6) pump (HP) (yield gpm) 50 Gpm			
(type power)			
(7) electric log (yes or no) no			
(organization running log)	Rec'd 240 10-21-81		
(8) how well bottom plugged wood plug			
DRILLERS REMARKS:			

If well telescopes please
sketch and show depths.

GROUND LEVEL

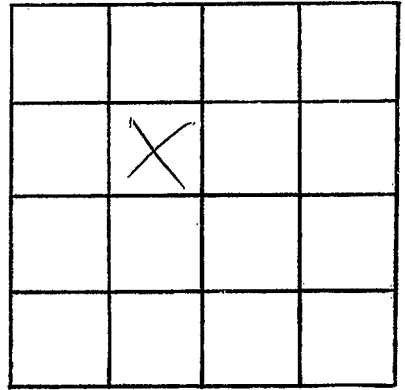

SECTION 28

Please indicate well location X.

ADDITIONAL INFORMATION

If more than one screen,
show locations of each on sketch.