

MISSISSIPPI DEPARTMENT OF NATURAL RESOURCES

Bureau of Land and Water Resources

Southport Mall

P.O. Box 10631

Jackson, Mississippi 39209

WATER WELL DRILLERS LOG

WILKINSON
 037D
 10/24/82

Oct 24, 1982 Brunfield Well Service Wilkinson
 date well completed firm name county well located

LANDOWNER:	description of formations encountered	from	to
<u>Energy Drilling Co.</u>			
<u>Liberty Rd Natchez</u> (mailing address)	<u>Red Sand</u>	<u>12</u>	<u>27</u>
WELL LOCATION:	<u>Chalk</u>	<u>27</u>	<u>65</u>
sec. <u>25</u> T. <u>4</u> N. R. <u>1</u> E	<u>Fine Sand</u>	<u>65</u>	<u>125</u>
<u>3</u> miles <u>W-SW</u> of <u>Rosetta</u>	<u>Coarse Sand</u>	<u>125</u>	<u>148</u>
(distance) (direction) (nearest town)	<u>Fine Packy Sand</u>	<u>148</u>	<u>461</u>
WELL PURPOSE: <u>For Oil Well</u>	<u>Coarse Sand</u>	<u>461</u>	<u>503</u>
(home, irrigation, municipal, industrial)	<u>Husman oil & Royalty</u>		
WELL COMPLETION DATA:	<u>#1 USA 25-14</u>		
(1) diameter (inches) <u>3"</u>	<u>929° N & 2238° E by SW/409</u>		
(2) total depth (feet) <u>503'</u>	<u>Sec 25, T4N, R1E</u>		
(3) static water level (feet) <u>190</u> below top of ground.			
(4) casing <u>Steel</u> , <u>482'</u> (material) (depth)			
<u>3"</u> if telescope see back. (size)			
(5) screen <u>21'</u> , <u>482'</u> (length) (depth to top)			
<u>3"</u> <u>Steel</u> (size) (material)			
(6) pump <u>Air</u> , <u>50</u> (HP) (yield gpm)			
<u>Diesel</u> (type power)			
(7) electric log <u>No</u> (yes or no)			
(organization running log)			
(8) how well bottom plugged <u>Cap</u>			
DRILLERS REMARKS: <u>Well pulled & Abandoned</u>			

CODED


DEPT. OF NATURAL RESOURCES
 BUREAU OF LAND & WATER RESOURCES

NOV 16 1982

RECEIVED

If well telescopes please sketch and show depths.

GROUND LEVEL

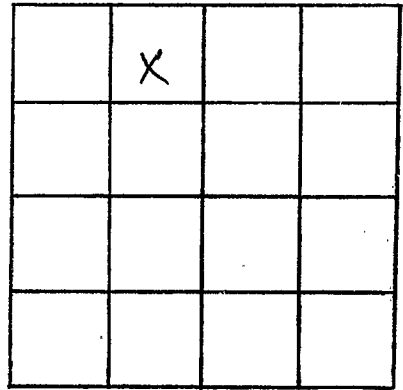

SECTION 25

Please indicate well location X.

ADDITIONAL INFORMATION

If more than one screen,
show locations of each on sketch.