

MISSISSIPPI DEPARTMENT OF NATURAL RESOURCES

Bureau of Land and Water Resources

Southport Mall

P.O. Box 10631

Jackson, Mississippi 39209

CODED

WATER WELL DRILLERS LOG

WILKINSON  
 039  
 9/14/83

9/14/1983  
 date well completed

Rayson Drilling  
 firm name

Wilkinson  
 county well located

LANDOWNER:  
 Shamrock Drilling  
 Natchez, Miss  
 (mailing address)

description of formations encountered	from	to
Top Soil	0	4
Salt	5	140
Sand	141	225

WELL LOCATION:  
 sec. 28 T. 4 N. R. 1 E  
 2 miles South of Rosetta  
 (distance) (direction) (nearest town)

WELL PURPOSE: Oil Field  
 (home, irrigation, municipal, industrial)

CODED

- WELL COMPLETION DATA:
- (1) diameter (inches) 3"
  - (2) total depth (feet) 225'
  - (3) static water level (feet) 120' below above top of ground.
  - (4) casing Blk, 205' (material) (depth)  
 3" if telescope see back. (size)
  - (5) screen 20', 205' (length) (depth to top)  
 3" (size) Blk (material)
  - (6) pump 52 (HP) (yield gpm)  
 (type power)
  - (7) electric log (yes or no)  
 (organization running log)
  - (8) how well bottom plugged wood plug

ROLLING # 3

DEPT. OF NATURAL RESOURCES  
 BUREAU OF LAND & WATER RESOURCES


NOV 28 1983

RECEIVED

DRILLERS REMARKS:

If well telescopes please sketch and show depths.

GROUND LEVEL

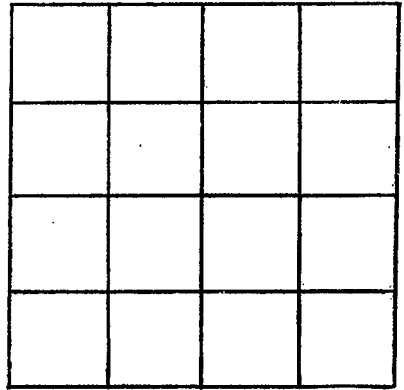

SECTION \_\_\_\_\_

Please indicate well location X.

ADDITIONAL INFORMATION

If more than one screen,  
show locations of each on sketch.