

MISSISSIPPI DEPARTMENT OF NATURAL RESOURCES

Bureau of Land and Water Resources

Southport Mall

P.O. Box 10631

Jackson, Mississippi 39209 CODED

WATER WELL DRILLERS LOG

WILKINSON
D 40
12/8/83

12-8 1983 Rayhorn Drill & Const. Co. Wilkinson
date well completed firm name county well located

LANDOWNER:	description of formations encountered	from	to
Shamrock Drilling	Top soil	0	20
Natchez, Ms. 39120 (mailing address)	sand	20	112
WELL LOCATION: sec. 33 T 4 N R 1 E S W	gravel	112	240
(distance) miles of (direction) (nearest town)	Red sand	240	290
WELL PURPOSE: <i>Red Sand/Gravel</i> (home, irrigation, municipal, industrial)	shale	290	340
WELL COMPLETION DATA:	Broken sand/shale	340	397
(1) diameter (inches) 3 11	sand	397	431
(2) total depth (feet) 431'			
(3) static water level (feet) 120' below top of ground.			
(4) casing <i>Blk</i> 431' (material) (depth)			
3 11 (size) if telescope see back.			
(5) screen 30' 411' (length) (depth to top)			
3 11 (size) slotted pipe (material)			
(6) pump 52 Gpm (HP) (yield gpm)			
(type power)			
(7) electric log <i>no</i> (yes or no)			
(organization running log)			
(8) how well bottom plugged <i>Well plug</i>			
DRILLERS REMARKS:			


DEPT. OF NATURAL RESOURCES
BUREAU OF LAND & WATER RESOURCES

DEC 12 1983

RECEIVED

If well telescopes please sketch and show depths.

GROUND LEVEL

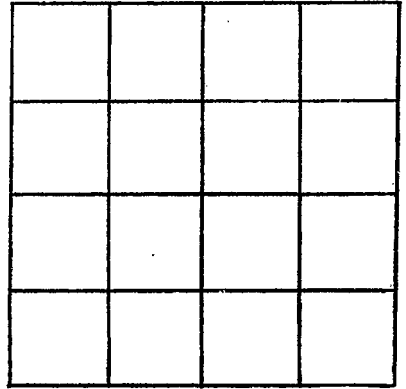

SECTION _____

Please indicate well location X.

ADDITIONAL INFORMATION

If more than one screen,
show locations of each on sketch.