

MISSISSIPPI DEPARTMENT OF NATURAL RESOURCES

Bureau of Land and Water Resources

Southport Mall

P.O. Box 10631

CODED

Jackson, Mississippi 39209

WATER WELL DRILLERS LOG

D40
Wilkinson
6-17-84

6/12/84 date well completed
Raybon Drilling firm name
Wilkinson county well located

LANDOWNER: D & D Drilling
P.O. Box 351
Fern'day, LA 71334
(mailing address)

description of formations encountered	from	to
Chalk	0	30
Blue Chalk	31	50
sand	51	150

WELL LOCATION:
sec. 40 T. 4 N. R. 1 E
3 miles SW of Crosby
(distance) (direction) (nearest town)

WELL PURPOSE: oilfield
(home, irrigation, municipal, industrial)

WELL COMPLETION DATA:

(1) diameter (inches) 3"

(2) total depth (feet) 150'

(3) static water level (feet) 75' below top of ground.

(4) casing blk pipe, 130'
(material) (depth)
3" if telescope see back.
(size)

(5) screen 20' 130'
(length) (depth to top)
3" slotted pipe
(size) (material)

(6) pump 50
(HP) (yield gpm)

(type power)

(7) electric log NO
(yes or no)

(organization running log)

(8) how well bottom plugged wood

lease Name:
Jay Heirs #1
45' N 30' W, OF SE/4 COR
SE NW SEC.

DEPT. OF NATURAL RESOURCES
BUREAU OF LAND & WATER RESOURCES


JUL 17 1984

RECEIVED

DRILLERS REMARKS:

If well telescopes please sketch and show depths.

GROUND LEVEL

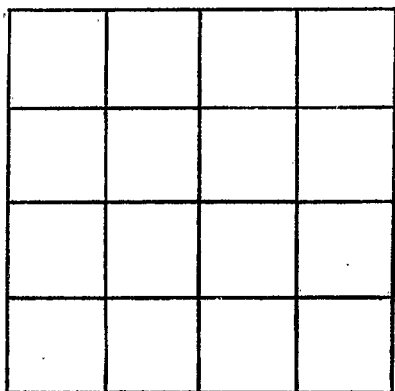

SECTION _____

Please indicate well location X.

ADDITIONAL INFORMATION

If more than one screen,
show locations of each on sketch.

9