

MISSISSIPPI DEPARTMENT OF NATURAL RESOURCES

Bureau of Land and Water Resources

Southport Mall

P.O. Box 10631

Jackson, Mississippi 39209

WATER WELL DRILLERS LOG

CODED

WILKINSON
D42

8/27, 1984 Rayborn Drilling Wilkinson
date well completed firm name county well located

LANDOWNER:	description of formations encountered	from	to
Shamrock Drilling	Top Soil	0	8'
Natchez, MS 39128 (mailing address)	Chalk	9	45
WELL LOCATION:	Sand + Gravel	40	150
sec. 10 T. 4 N. 1 R. 1 E 2 miles west of Rosetta (distance) (direction) (nearest town)			
WELL PURPOSE: <u>irrigation</u> (home, irrigation, municipal, industrial)			
WELL COMPLETION DATA:			
(1) diameter (inches) 4"			
(2) total depth (feet) 150'			
(3) static water level (feet) 25' below top of ground.			
(4) casing black pipe, 130' (material) (depth)			
4" if telescope see back. (size)			
(5) screen 20' 130' (length) (depth to top)			
4" slotted pipe (size) (material)			
(6) pump — 50 (HP) (yield gpm)			
(type power)			
(7) electric log <u>no</u> (yes or no)			
(organization running log)			
(8) how well bottom plugged <u>wood</u>			

CODED

North Kelly Hill #1

DEPT. OF NATURAL RESOURCES
BUREAU OF LAND & WATER RESOURCES


NOV 9 1984

RECEIVED

DRILLERS REMARKS:

If well telescopes please sketch and show depths.

GROUND LEVEL

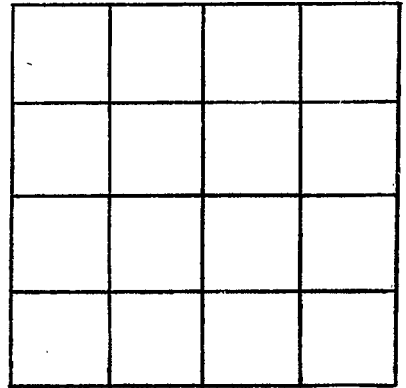

SECTION _____

Please indicate well location X.

ADDITIONAL INFORMATION

If more than one screen,
show locations of each on sketch.