

MISSISSIPPI DEPARTMENT OF NATURAL RESOURCES

Bureau of Land and Water Resources

Southport Mall

P.O. Box 10631

Jackson, Mississippi 39209

WATER WELL DRILLERS LOG

CODED

WILKINSON  
D43

115 1984 Raybon Drilling Wilkinson  
date well completed firm name county well located

LANDOWNER:  
David New Drilling  
Natchez, MS  
(mailing address)

WELL LOCATION:  
sec 34 T 4 N R 1 E  
3 miles west of Crosby  
(distance) (direction) (nearest town)

WELL PURPOSE: oilfield  
(home, irrigation, municipal, industrial)

- WELL COMPLETION DATA:
- (1) diameter (inches) 3"
  - (2) total depth (feet) 474'
  - (3) static water level (feet) 200' below top of ground.
  - (4) casing blk pipe, 4 1/4" (material) (depth)  
3" if telescope see back. (size)
  - (5) screen 20' 4 1/4" (length) (depth to top)  
3" slotted pipe (size) (material)
  - (6) pump 50 (HP) (yield gpm)  
(type power)
  - (7) electric log NO (yes or no)  
(organization running log)
  - (8) how well bottom plugged wood

description of formations encountered	from	to
Top Soil	0	2
Gravel	3	30
Chalk	31	305
Sand	300	380
Chalk	381	387
Sand	388	474

LEASE NAME:  
USA 34-1 #1  
2386' S & 1824' W of NE 1 cor


DEPT. OF NATURAL RESOURCES  
BUREAU OF LAND & WATER RESOURCES

RECEIVED  
OCT 31 1984

DRILLERS REMARKS:

If well telescopes please  
sketch and show depths.

GROUND LEVEL

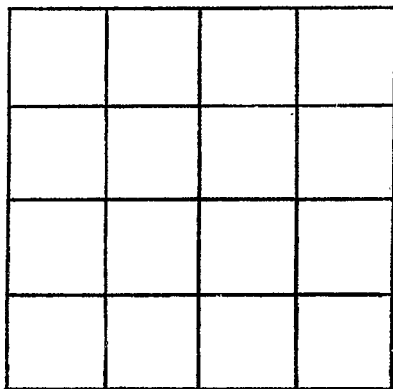

SECTION \_\_\_\_\_

Please indicate well location X.

ADDITIONAL INFORMATION

If more than one screen,  
show locations of each on sketch.