

MISSISSIPPI DEPARTMENT OF NATURAL RESOURCES

Bureau of Land and Water Resources

Southport Mall

P.O. Box 10631

Jackson, Mississippi 39209

WATER WELL DRILLERS LOG

CODED

D45
Wilkinson
7-29-85

7/29 1985 Rayborn Drlg. Co. Wilkinson
 date well completed firm name county well located

LANDOWNER: <u>David New Drlg.</u>	description of formations encountered	from	to
<u>PO Box 1487</u>			
<u>Natchez Ms 39120</u> (mailing address)	<u>sand & Gravel</u>	<u>10</u>	<u>35</u>
WELL LOCATION: sec. <u>24</u> T. <u>4</u> N. R. <u>1</u> E S W	<u>Gumbo</u>	<u>35</u>	<u>280</u>
<u>3</u> miles <u>W</u> of <u>Rosetta</u> (distance) (direction) (nearest town)	<u>Streaked sand</u>	<u>280</u>	<u>350</u>
WELL PURPOSE: <u>airfold use</u> (home, irrigation, municipal, industrial)	<u>Sand</u>	<u>350</u>	<u>395</u>
WELL COMPLETION DATA:	<u>#24-14 USA "N"</u>		
(1) diameter (inches) <u>3"</u>			
(2) total depth (feet) <u>395'</u>			
(3) static water level (feet) <u>100'</u> <u>below</u> top of ground.	<u>205' N 71 W 1' E of SW COR</u>		
(4) casing <u>steel pipe</u> , <u>375'</u> (material) (depth)	<u>SG 24-4N-16</u>		
<u>3"</u> (size) if telescope see back.			
(5) screen <u>20'</u> , <u>375'</u> (length) (depth to top)			
<u>3"</u> , <u>slotted pipe</u> (size) (material)			
(6) pump <u>—</u> , <u>50</u> (HP) (yield gpm)			
<u>electric</u> (type power)			
(7) electric log <u>no</u> (yes or no)			
<u>—</u> (organization running log)			
(8) how well bottom plugged <u>wood</u>			


RECEIVED
 OCT - 8 1985

Department of Natural Resources
 Bureau of Land & Water Resources

DRILLERS REMARKS: —

If well telescopes please sketch and show depths.

GROUND LEVEL

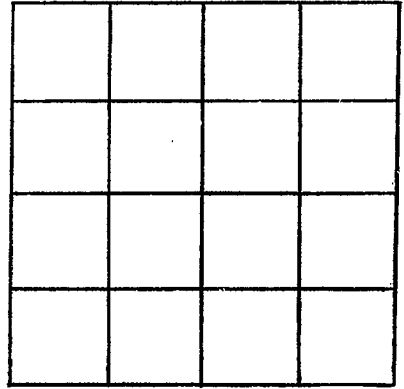

SECTION _____

Please indicate well location X.

ADDITIONAL INFORMATION

If more than one screen,
show locations of each on sketch.