

CODED

MISSISSIPPI DEPARTMENT OF NATURAL RESOURCES

Bureau of Land and Water Resources

COUNTY WELL LOCATED
 Wilkinson
 WELL NUMBER
 D 48
 CODED
 DATE WELL COMPLETED
 5-16-88

PERMIT NUMBER
 RAYBORN DRILLING, INC.
 P.O. Box 98
 Natchez MS 39120

P.O. Box 10631
 Jackson, Mississippi 39209
 WATER WELL DRILLERS LOG

NAME & MAILING ADDRESS OF LANDOWNER
 Shamrock Drilling
 P.O. Box 2210
 Natchez MS 39120
 WELL LOCATION: SEC 27 TOWNSHIP 4 N RANGE 1 E
 DISTANCE 2 Miles DIRECTION SW of NEAREST TOWN Rosetta
 OTHER LANDMARK
 WELL PURPOSE: Home, Irrigation, Municipal, Industrial, Fish Pond, etc.
 Oilfield

PUMP DATA
 PUMP TYPE (Circle One): Submersible, Turbine, Jet, Flowing Well, Other (Describe) Air
 POWER TYPE (Circle One): Electric, Tractor, Diesel, Gasoline, Butane, Other (Describe)
 Pump Capacity (GPM) No. of Stages Setting Depth FT.
 PUMP TEST
 Well yielded 50 GPM with a drawdown of _____ ft. after _____ hours of pumping

WELL DATA
 Well Depth 300' Casing Diameter (in.) 3" Casing Length (Ft.) 290'
 Type of Casing Sch 40 PVC Hole Depth 300' Depth to Static Water Level 100'
 TYPE OF COMPLETION: (Circle One or More): Gravel Packed, Underreamed, Telescoped, Natural Development, Open Hole, Other
 Top of Lap Pipe or Reduction in Casing FEET IF TELESCOPED OR MORE THAN ONE SCREEN: USE BACK PAGE

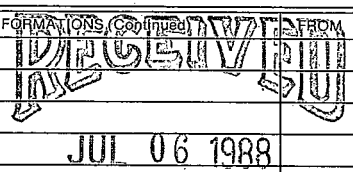
LOG DATA
 TYPE OF LOG RUN (Circle One): No Log Run, Electric, Gamma Ray, Density, Sonic, Neutron, Other (Describe)
 Name of Organization Running Log

SCREEN DATA
 Diameter - Inches 3" Length - Feet 10' Slot Size - Inches .020
 Screen Type Sch 40 Slotted PVC Depth to Bottom - Feet 300'

GEOLOGIC DATA (Office Use Only)

Surface Elev.	Geologic Unit	Unit Thickness	Depth to Top
Subs. SWL	Date	Analysis	Aquifer Test

 Driller's Remarks

DESCRIPTION OF FORMATIONS ENCOUNTERED	FROM	TO	FORMATIONS (Continued)	FROM	TO
Top Soil	0	2			
Clay	2	125			
Sand	125	300			
Department of Natural Resources Bureau of Land & Water Resources					
IF MORE SPACE IS NEEDED, USE BACK					

If well telescopes please
sketch and show depths.

GROUND LEVEL

SECTION _____

Please indicate well location X.

ADDITIONAL INFORMATION

If more than one screen,
show location of each on sketch.