

MISSISSIPPI DEPARTMENT OF ENVIRONMENTAL QUALITY
Bureau of Land and Water Resources

P. O. Box 10631
Jackson, MS 39289-0631
WATER WELL DRILLERS LOG

COUNTY WELL LOCATED <i>Wilkinson</i>	
WELL NUMBER <i>Ogden A11</i>	CODED <i>D 50</i>
DATE WELL COMPLETED <i>4-29-92</i>	

PERMIT NUMBER <i>0-453</i>
NAME OF DRILLING FIRM <i>Morphis Brother</i>
<i>Trout, La 71371</i>

NAME & MAILING ADDRESS OF LANDOWNER <i>Oxy Usa</i>		
<i>P.O. Box 27570</i>		
<i>Houston, Texas 77227</i>		
WELL LOCATION: SEC	TOWNSHIP	RANGE
<i>23</i>	<i>4</i>	<i>N 1 E</i>
DISTANCE	DIRECTION	NEAREST TOWN:
<i>3</i> Miles	<i>W</i>	<i>of Rossetta</i>
OTHER LANDMARK <i>1091' N & 934' W of SE/Cor</i>		
WELL PURPOSE: Home, Irrigation, Municipal, Industrial, Fish Pond, etc. <i>Rig Supply</i>		

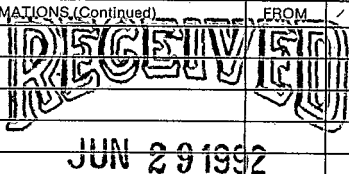
PUMP DATA		
PUMP TYPE (Circle One): <u>Submersible</u> Turbine, Jet, Flowing Well, Other (Describe) _____		
POWER TYPE (Circle One): <u>Electric</u> Tractor, Diesel, Gasoline, Butane, Other (Describe) _____ H/P <u>5</u>		
Pump Capacity (GPM)	No. of Stages	Setting Depth
		FT.
PUMP TEST		
Well yielded <u>75</u> GPM with a drawdown of _____ ft. after _____ hours of pumping		

WELL DATA		
Well Depth <i>220</i>	Casing Diameter (In.) <i>4</i>	Casing Length (Ft.) <i>190</i>
Type of Casing <i>PVC</i>	Hole Depth <i>220</i>	Depth to Static Water Level
TYPE OF COMPLETION: (Circle One or More): <u>Gravel Packed</u> Underreamed, Telescoped, Natural Development, Open Hole, Other (Describe) _____		
Top of Lap Pipe or Reduction in Casing		
FEET	IF TELESCOPED OR MORE THAN ONE SCREEN: USE BACK PAGE	

LOG DATA	
TYPE OF LOG RUN (Circle One): No Log Run, Electric, Gamma Ray, Density, Sonic, Neutron, Other (Describe) _____	
Name of Organization Running Log	

SCREEN DATA		
Diameter - Inches <i>4</i>	Length - Feet <i>30</i>	Slot Size - Inches <i>.020</i>
Screen Type <i>PVC</i>	Depth to Bottom - Feet	

GEOLOGIC DATA (Office Use Only)			
Surface Elev.	Geologic Unit	Unit Thickness	Depth to Top
Subs. SWL	Date	Analysis	Aquifer Test
Driller's Remarks			

DESCRIPTION OF FORMATIONS ENCOUNTERED	FROM	TO	FORMATIONS (Continued)	FROM	TO
<i>Clay & Sand</i>	<i>0</i>	<i>20</i>			
<i>Hard clay</i>	<i>20</i>	<i>40</i>			
<i>Red & Gray clay w/sdy Strks</i>	<i>40</i>	<i>60</i>			
<i>Sandy - Clay</i>	<i>60</i>	<i>80</i>			
<i>Clay & Sdy Clay</i>	<i>80</i>	<i>100</i>			
<i>Clay & Sdy Clay</i>	<i>100</i>	<i>120</i>			
<i>Sdy & Hard clay</i>	<i>120</i>	<i>140</i>			
<i>Gumbo w/sd Brks</i>	<i>140</i>	<i>160</i>			
<i>Gumbo w/sd Brks</i>	<i>160</i>	<i>180</i>			
<i>Sand-Med coarse white sand</i>	<i>180</i>	<i>220</i>			
<i>bottom white clay</i>					

IF MORE SPACE IS NEEDED, USE BACK

If well telescopes please
sketch and show depths.

GROUND LEVEL

SECTION _____

Please indicate well location X.

ADDITIONAL INFORMATION

If more than one screen,
show location of each on sketch.