

Wilkinson  
D 2001  
4/27/76

MISSISSIPPI  
 BOARD OF WATER COMMISSIONERS  
 416 North State Street  
 Jackson, Mississippi 39201

WATER WELL DRILLERS LOG

April 27 1976 Peewee Wilcox Wilkinson  
 date well completed firm name county well located

LANDOWNER:

Mr. W. R. Brunfield Jr  
Rosetta Miss  
 (mailing address)

description of formations encountered

from to

<u>Sh Clay</u>	<u>0</u>	<u>10</u>
<u>sand &amp; gravel</u>	<u>10</u>	<u>40</u>
<u>blue Chalk</u>	<u>40</u>	<u>60</u>
<u>fine sand</u>	<u>60</u>	<u>70</u>
<u>blue Chalk</u>	<u>70</u>	<u>190</u>
<u>Coarse sand</u>	<u>190</u>	<u>218</u>

WELL LOCATION:

sec. 21 T. 4 N. R. 1 E  
in Rosetta  
 (distance) (direction) (nearest town)

WELL PURPOSE: house  
 (home, irrigation, municipal, industrial)

WELL COMPLETION DATA:

- (1) diameter (inches) 4"
- (2) total depth (feet) 218
- (3) static water level (feet) 30 below top of ground.
- (4) casing plastic bottom  
 (material) (depth)
- If telescope see back.  
 (size)
- (5) screen 6" 212  
 (length) (depth to top)  
4" plastic  
 (size) (material)
- (6) pump 1/2 Sub 10  
 (HP) (yield gpm)  
elect  
 (type power)
- (7) electric log no  
 (yes or no)
- (organization running log)

(8) how well bottom plugged  
Wooden plug


DRILLERS REMARKS:  
no remark

RECEIVED  
 JUL - 8 1976

MISS. BD. OF WATER COMMISSIONERS

If well telescopes please sketch and show depths.

GROUND LEVEL

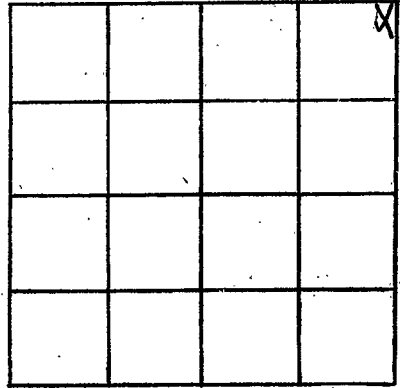

SECTION 21

Please indicate well location X.

ADDITIONAL INFORMATION

A series of horizontal lines for recording additional information.

If more than one screen, show locations of each on sketch.