

WILKINSON
 D 2002
 5/31/77

MISSISSIPPI
 BOARD OF WATER COMMISSIONERS
 416 North State Street
 14A Jackson, Mississippi 39201

57

WATER WELL DRILLERS LOG

May 31 1977 Russ Well Co Wilkinson
 date well completed firm name county well located

BANDOWNER:
Larry Anderson
Rt 1 Crosby
 (mailing address)

description of formations encountered	from	to
Red Clay	0	18
Sand + pea gravel	18	50
Chalk	50	55
Coarse sand	55	64

WELL LOCATION:
 sec 37 T 4 N R 1 E
4 1/2 miles W of CROSBY
 (distance) (direction) (nearest town)

WELL PURPOSE: home
 (home, irrigation, municipal, industrial)

- WELL COMPLETION DATA:
- (1) diameter (inches) 4'
 - (2) total depth (feet) 64'
 - (3) static water level (feet) 40 below top of ground.
 - (4) casing plastic bottom
 (material) (depth)
 - if telescope see back.
 (size)
 - (5) screen 5' 59'
 (length) (depth to top)
 - 4" plastic
 (size) (material)
 - (6) pump 65 athus
 (HP) (yield gpm)
 - 1/2
 (type power)
 - (7) electric log no
 (yes or no)
 - (organization running log)

(8) how well bottom plugged wooden plug


DRILLERS REMARKS:

RECEIVED

AUG 26 1977

If well telescopes please sketch and show depths.

GROUND LEVEL

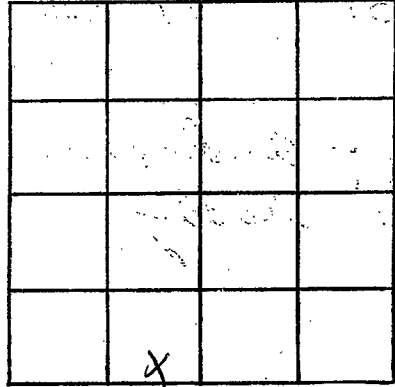

SECTION 37

Please indicate well location X.

ADDITIONAL INFORMATION

If more than one screen,
show locations of each on sketch.