

Wilkinson
D 2003
7/29/77

MISSISSIPPI
 BOARD OF WATER COMMISSIONERS
 416 North State Street
 Jackson, Mississippi 39201

(94)

WATER WELL DRILLERS LOG

July 29 1977 Reynolds Wilkinson
 date well completed firm name county well located

LANDOWNER:

M. L. Perry
Rt 1 Crosskey
 (mailing address)

description of formations encountered

from

to

clay	0	30
sand & gravel	30	55
white & blue chalk	55	160
fine sand	160	185
coarse sand	185	204

WELL LOCATION:

sec. 21 T. 4 N. R. 1 E.

in Rosetta
 (distance) (direction) (nearest town)

WELL PURPOSE:

home
 (home, irrigation, municipal, industrial)

WELL COMPLETION DATA:

- (1) diameter (inches) 4"
- (2) total depth (feet) 204
- (3) static water level (feet) 62 below top of ground.
- (4) casing plastic bottom
(material) (depth)
- (5) screen 6' 198'
(length) (depth to top)
- (6) pump 1/2 HP 10
(type power) (yield gpm)
- (7) electric log no
(yes or no)

(organization running log)

(8) how well bottom plugged

wooden plug


DRILLERS REMARKS:

RECEIVED
 DEC 29 1977

MISS. BD. OF WATER COMAR

If well telescopes please
sketch and show depths.

GROUND LEVEL

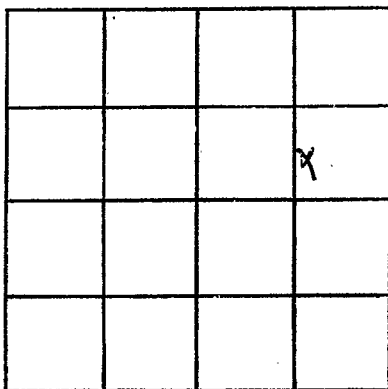

SECTION 21

Please indicate well location X.

ADDITIONAL INFORMATION

If more than one screen,
show locations of each on sketch.