

MISSISSIPPI DEPARTMENT OF NATURAL RESOURCES

Bureau of Land and Water Resources

Southport Mall.

P.O. Box 10631

Jackson, Mississippi 39209

WATER WELL DRILLERS LOG

Wilkinson
D 3004
10-10-80

Oct 10 1979 Reverz Miller Wilkinson
 date well completed firm name county well located

LANDOWNER:
Harold Wood
Rt Crosby
 (mailing address)

description of formations encountered	from	to
<u>Clay</u>	<u>0</u>	<u>12</u>
<u>sand & gravel</u>	<u>12</u>	<u>27</u>
<u>Chalk & lobby</u>	<u>27</u>	<u>65</u>
<u>sand & gravel</u>	<u>65</u>	<u>78</u>

WELL LOCATION:
 sec. 35 T 4 N R 1 E
4 1/2 miles West of Crosby
 (distance) (direction) (nearest town)

WELL PURPOSE: Family
 (home, irrigation, municipal, industrial)

- WELL COMPLETION DATA:
- (1) diameter (inches) 4"
 - (2) total depth (feet) 78'
 - (3) static water level (feet) 60' below top of ground.
 - (4) casing plastic bottom
 (material) (depth)
 - 5' if telescope see back.
 (size)
 - (5) screen 5' 73'
 (length) (depth to top)
 - 4" plastic
 (size) (material)
 - (6) pump weather
 (HP) (yield gpm)
 - shot
 (type power)
 - (7) electric log no
 (yes or no)
 - ✓
 (organization running log)

DEPT. OF NATURAL RESOURCES
 BUREAU OF LAND & WATER RESOURCES

OCT - 9 1980


RECEIVED

(8) how well bottom plugged
wooder plug

DRILLERS REMARKS:
✓

If well telescopes please sketch and show depths.

GROUND LEVEL

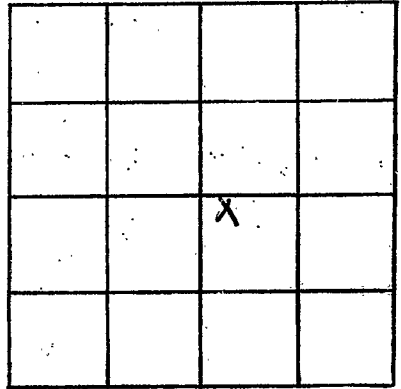

SECTION 35

Please indicate well location X.

ADDITIONAL INFORMATION

If more than one screen,
show locations of each on sketch.