

MISSISSIPPI DEPARTMENT OF NATURAL RESOURCES

Bureau of Land and Water Resources

Southport Mall

P.O. Box 10631

Jackson, Mississippi 39209

WATER WELL DRILLERS LOG

*Wilkinson*  
*D. Perry*  
*2000*

*2-19* 19 *82*  
 date well completed

*Perry Wilkin Wilkinson*  
 firm name

county well located

LANDOWNER:  
*Janita Perry*  
*Rt 1 Crosby*  
 (mailing address)

description of formations encountered	from	to
<i>Clay</i>	<i>0</i>	<i>5</i>
<i>white sand</i>	<i>5</i>	<i>55</i>
<i>Clay sand &amp; gravel</i>	<i>55</i>	<i>85</i>
<i>Coarse sand</i>	<i>85</i>	<i>170</i>

WELL LOCATION:  
 sec. *39* T *4* R *1*  
*3 1/2* miles *W* of *Crosby*  
 (distance) (direction) (nearest town)

WELL PURPOSE: *Water*  
 (home, irrigation, municipal, industrial)

- WELL COMPLETION DATA:
- (1) diameter (inches) *4"*
  - (2) total depth (feet) *180*
  - (3) static water level (feet) *80* below top of ground.
  - (4) casing *plastic bottom* (material) (depth)
  - (size) If telescope see back.
  - (5) screen *5'* *115'* (length) (depth to top)  
*4"* *plastic* (size) (material)
  - (6) pump *sub* *10* (HP) (yield gpm)  
*split* (type power)
  - (7) electric log *no* (yes or no)  
 (organization running log)
  - (8) how well bottom plugged  
*back wash*

DRILLERS REMARKS:  
*/*


DEPT. OF NATURAL RESOURCES  
 BUREAU OF LAND & WATER RESOURCES

JUL 15 1982

RECEIVED

If well telescopes please sketch and show depths.

GROUND LEVEL

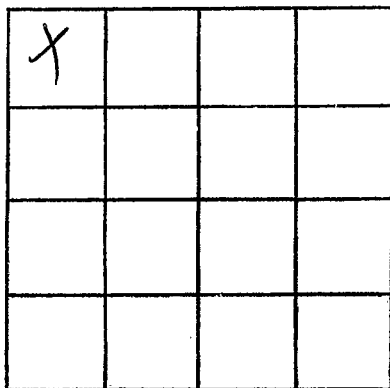

SECTION 39

Please indicate well location X.

ADDITIONAL INFORMATION

If more than one screen,  
show locations of each on sketch.